

Lowndes
D 2002
7-15-76

MISSISSIPPI
 BOARD OF WATER COMMISSIONERS
 416 North State Street
 Jackson, Mississippi 39201

WATER WELL DRILLERS LOG

7-15 1976 MID SOUTH DRILLING LOWNDES
 date well completed firm name county well located

LANDOWNER: Roy Brittle
Stens Mississippi
 (mailing address)

WELL LOCATION:
 sec. 2 T. 17 N. R. 12 E
 S W
4 miles NE of STENS
 (distance) (direction) (nearest town)

WELL PURPOSE: Home
 (home, irrigation, municipal, industrial)

WELL COMPLETION DATA: 7-16-76

- (1) diameter (inches) 4"
- (2) total depth (feet) 112
- (3) static water level (feet) 40 below top of ground.
- (4) casing PVC, 92 + 20' more
 (material) (depth)
4" if telescope see back.
 (size)
- (5) screen 20, 92
 (length) (depth to top)
4, PVC
 (size) (material)
- (6) pump 1/2, 15
 (HP) (yield gpm)
Electric
 (type power)
- (7) electric log No
 (yes or no)
 (organization running log)
- (8) how well bottom plugged wash valve

description of fomations encountered	from	to
<u>red clay gravel</u>	<u>0</u>	<u>24</u>
<u>blue clay</u>	<u>24</u>	<u>78</u>
<u>sand</u>	<u>78</u>	<u>81</u>
<u>clay</u>	<u>81</u>	<u>92</u>
<u>sand</u>	<u>92</u>	<u>99</u>
<u>clay</u>	<u>99</u>	<u>103</u>
<u>sand</u>	<u>103</u>	<u>112</u>

RECEIVED


NOV 15 1976

MISS. Bd. OF WATER COMMISSIONERS

DRILLERS REMARKS:

If well telescopes please sketch and show depths.

GROUND LEVEL

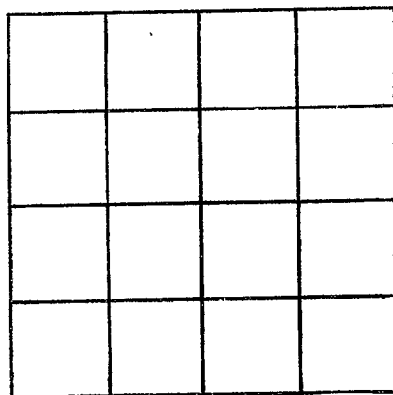

SECTION _____

Please indicate well location X.

ADDITIONAL INFORMATION

If more than one screen, show locations of each on sketch.