

LOWNDES

D 2003

1-28-77

MISSISSIPPI  
 BOARD OF WATER COMMISSIONERS  
 416 North State Street  
 Jackson, Mississippi 39201

13L

WATER WELL DRILLERS LOG

1-28  
date well completed

1977 Mid South Drilling Co.  
firm name

Lowndes  
county well located

LANDOWNER:  
 Sean Morgan  
 Columbus, Miss.  
 (mailing address)


description of fomations encountered	from	to
Sand & Gravel	0	23
Blue shale	23	132
Blue shale & sand streaks	132	210

WELL LOCATION:  
 sec. 17 T. 17 N. R. 17 E.  
 S  
 2 1/2 miles N of Steens  
 (distance) (direction) (nearest town)

WELL PURPOSE: none  
 (home, irrigation, municipal, industrial)


- WELL COMPLETION DATA:
- diameter (inches) 4"
  - total depth (feet) 210
  - static water level (feet) 20 below top of ground.
  - casing PVC, 140 (material), (depth)  
 4 (size) if telescope see back.
  - screen (length) (depth to top)  
 (size) (material)
  - pump 1/2 (HP), 60 (yield gpm)  
 Elect (type power)
  - electric log (yes or no)  
 (organization running log)
  - how well bottom plugged

DRILLERS REMARKS:

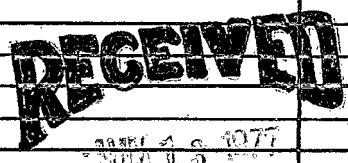

If well telescopes please sketch and show depths.

GROUND LEVEL

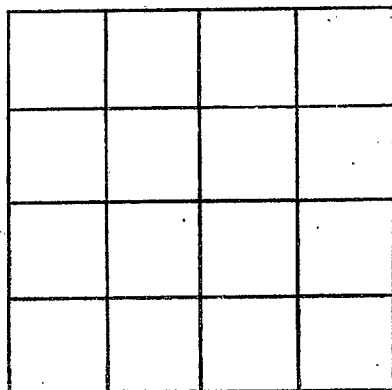

SECTION \_\_\_\_\_

Please indicate well location X.

ADDITIONAL INFORMATION

If more than one screen,  
show locations of each on sketch.