

MISSISSIPPI DEPARTMENT OF NATURAL RESOURCES

Bureau of Land and Water Resources

Southport Mall

P.O. Box 10631

Jackson, Mississippi 39209

WATER WELL DRILLERS LOG

<u>LOWNDES</u>
<u>D 2005</u>
<u>9-5-80</u>

9/5 1980 Clardy Well Drilling Lowndes
 date well completed firm name county well located

LANDOWNER: Robert Kay Steens, Miss.

description of formations encountered	from	to
<u>different color clays</u>	<u>0</u>	<u>145</u>
<u>blue clay</u>	<u>145</u>	<u>165</u>
<u>sand</u>	<u>165</u>	<u>195</u>

(mailing address)

WELL LOCATION:

sec. 16 T. 17 N. R. 17 E
6 miles So of Palmdown
 (distance) (direction) (nearest town)

WELL PURPOSE: home
 (home, irrigation, municipal, industrial)

WELL COMPLETION DATA:

- (1) diameter (inches) 4"
- (2) total depth (feet) 195
- (3) static water level (feet) 70 below top of ground.
- (4) casing PVC 145
 (material) (depth)
- if telescope see back.
 (size)
- (5) screen
 (length) (depth to top)
- (size) (material)
 (6) pump 1/2 800
 (HP) (yield gpm)
- (type power)
- (7) electric log no
 (yes or no)
- (organization running log)
- (8) how well bottom plugged open

DEPT. OF NATURAL RESOURCES
 BUREAU OF LAND & WATER RESOURCES


OCT 9 1980

RECEIVED

DRILLERS REMARKS:

If well telescopes please
sketch and show depths.

GROUND LEVEL

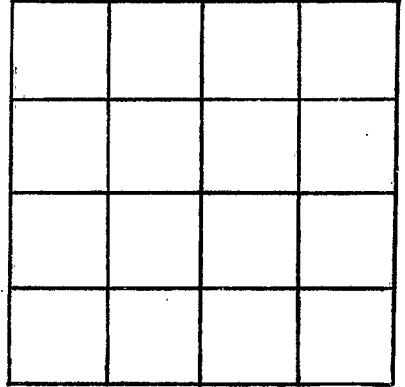

SECTION _____

Please indicate well location X.

ADDITIONAL INFORMATION

If more than one screen,
show locations of each on sketch.