

MISSISSIPPI DEPARTMENT OF NATURAL RESOURCES


Bureau of Land and Water Resources

Southport Mall

P.O. Box 10631

Jackson, Mississippi 39209

WATER WELL DRILLERS LOG

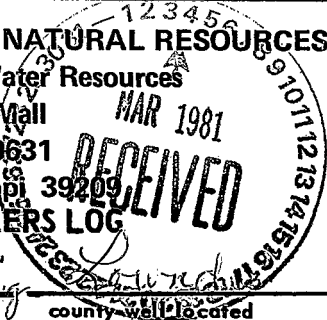

LOWMEDES  
D 2006  
2/21/81

2-121 1981 Clardy Well Drilling firm name: county well located

LANDOWNER: Ron Hepper  
Rt. 5 Box 5  
Columbus, Miss.  
(mailing address)


WELL LOCATION:  
sec. 22 T. 17 N. R. 11 E  
1/2 miles NE of Steers  
(distance) (direction) (nearest town)

WELL PURPOSE: home  
(home, irrigation, municipal, industrial)

- WELL COMPLETION DATA:
- (1) diameter (inches) 4"
  - (2) total depth (feet) 180'
  - (3) static water level (feet) 68' below top of ground.
  - (4) casing PVC, 112 - 4" (material) (depth)  
(size) if telescope see back.
  - (5) screen 30' (length) (depth to top)  
2" PVC (size) (material)
  - (6) pump 1 (HP) 1400 gph. (yield gpm)  
o.b.c. (type power)
  - (7) electric log no (yes or no)  
(organization running log)
  - (8) how well bottom plugged Sand Shank

description of formations encountered	from	to
Gravel	12	28
Clay	28	58
Rock	58	58 1/2
Clay	58 1/2	69
Sand	69	71 1/2
Clay	71 1/2	74
Sand	74	76 1/2
Clay	76 1/2	90
Small rocks	90	
Clay	90	142
Sand	142	175
Clay	175	180

DEPT. OF NATURAL RESOURCES  
BUREAU OF LAND & WATER RESOURCES

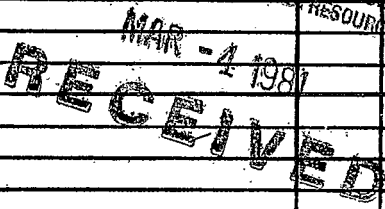

DRILLERS REMARKS:

