

Lowndes
Daton
9-6-80

MISSISSIPPI
 BOARD OF WATER COMMISSIONERS
 416 North State Street
 Jackson, Mississippi 39201

WATER WELL DRILLERS LOG

9-6 1980 ALLsup Drilling INC. Lowndes
 date well completed firm name county well located

LANDOWNER: Mrs. Mary Allen
JACKSON
R.R. 1, Box 45
Crawford, Ms. 39743
 (mailing address)

description of formations encountered	from	to
Top Soils	0	8
Lime Rock	8	400
SAND	400	460
Muds	460	500
2nd Sand	500	625

WELL LOCATION:
 sec 34-T-17-N R 17-E
6 miles E of Crawford
 (distance) (direction) (nearest town)

WELL PURPOSE: home
 (home, irrigation, municipal, industrial)

- WELL COMPLETION DATA:
- (1) diameter (inches) 4" x 2"
 - (2) total depth (feet) 625'
 - (3) static water level (feet) 100 below top of ground.
 - (4) casing plastic, 30'
 (material) (depth)
4" x 2" if telescope see back.
 (size)
 - (5) screen 20', 545'
 (length) (depth to top)
4" x 2", plastic
 (size) (material)
 - (6) pump 1/2, 12
 (HP) (yield gpm)
Electric
 (type power)
 - (7) electric log NO
 (yes or no)
- (organization running log)
- (8) how well bottom plugged CAP




DRILLERS REMARKS:

If well telescopes please sketch and show depths.

GROUND LEVEL

30'
4" casing

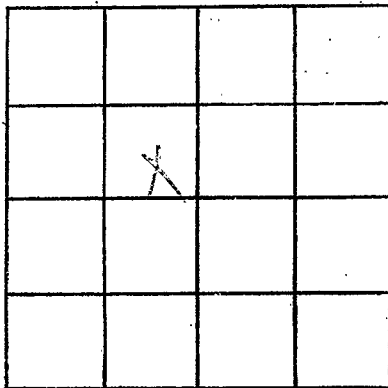

SECTION 34

Please indicate well location X.

ADDITIONAL INFORMATION

220' 2"
casing

30' 2"
Commercial
Screen

If more than one screen,
show locations of each on sketch.