

MISSISSIPPI DEPARTMENT OF NATURAL RESOURCES

Bureau of Land and Water Resources

Southport Mall

P.O. Box 10631

Jackson, Mississippi 39209

WATER WELL DRILLERS LOG

LOWNDES
D 2008
11-28-81

11-28
date well completed

81 Clardy Well Drilling Loundes
firm name county well located

LANDOWNER: Iva Jaggert
Rt 1 Box 463-A
Steens, MS 39766
(mailing address)

WELL LOCATION:
sec. 24 T 17 N R 17 E
6 miles NE of Calo.
(distance) (direction) (nearest town)

WELL PURPOSE: home
(home, irrigation, municipal, industrial)

WELL COMPLETION DATA:

(1) diameter (inches) 4"

(2) total depth (feet) 221'

(3) static water level (feet) 100' below top of ground.

(4) casing PRC, 147',
(material) (depth)
(size) if telescope see back.

(5) screen 20',
(length) (depth to top)
(size) (material)

(6) pump 1/2 300gph
(HP) (yield gpm)
elec.
(type power)

(7) electric log no.
(yes or no)
(organization running log)

(8) how well bottom plugged _____

description of formations encountered	from	to
gravel	8	15
red sandy clay	15	25
rock	25	
red clay	25	28
blue clay	28	75
red clay	75	79
blue clay	79	86 1/2
rock	86 1/2	
blue clay	86 1/2	141
rock	141	
good sand	141 1/2	144 1/2
clay	144 1/2	163 1/2
sand	163 1/2	179
clay	179	182 1/2
sand streaks	182 1/2	186 1/2
clay	186 1/2	191
sand streaks	191	191 1/2
clay	191 1/2	209
sand streaks	209	220
clay	220	221

DEPT. OF NATURAL RESOURCES
BUREAU OF LAND & WATER RESOURCES


DEC 13 1981

RECEIVED

DRILLERS REMARKS: _____

If well telescopes please sketch and show depths.

GROUND LEVEL

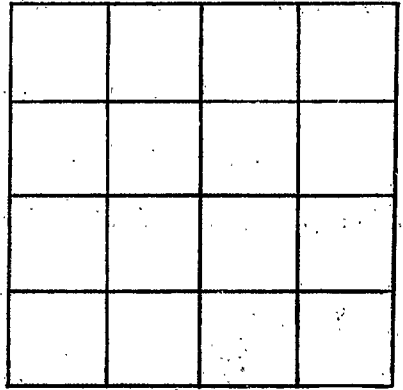

SECTION _____

Please indicate well location X.

ADDITIONAL INFORMATION

181

171 579

147' - 4"

59' - 2"

20' - 2"
Screen
Screen

If more than one screen, show locations of each on sketch.