

Lauderdale
AD
2010

MISSISSIPPI
 BOARD OF WATER COMMISSIONERS
 416 North State Street
 Jackson, Mississippi 39201

WATER WELL DRILLERS LOG

7-28 1982 Marks & Kilbray Lauderdale
 date well completed firm name county well located

LANDOWNER: Dr. J. R. Colburn
Columbus MS.
90 Bent Tree Community
 (mailing address)

description of formations encountered	from	to
<u>Blue Clay</u>	<u>0</u>	<u>170</u>
<u>Blue Clay & Sand</u>	<u>170</u>	<u>340</u>
<u>Sandstone</u>	<u>340</u>	<u>385</u>

WELL LOCATION:
 sec 29 T 17 N S R 17 E ND
 (distance) miles of (direction) (nearest town)

WELL PURPOSE:
 (home, irrigation, municipal, industrial)

WELL COMPLETION DATA:

(1) diameter (inches) 4"

(2) total depth (feet) 353'

(3) static water level (feet) 70 below above top of ground.

(4) casing PVC, 170'
 (material) (depth)

_____ if telescope see back.
 (size)

(5) screen _____ (length) _____ (depth to top)
 (size) _____ (material)

(6) pump 3/4 _____ 10
 (HP) (yield gpm)

E.
 (type power)

(7) electric log _____ (yes or no)
open hole

_____ (organization running log)

(8) how well bottom plugged _____

DEPT. OF NATURAL RESOURCES
 BUREAU OF LAND & WATER RESOURCES


AUG - 4 1982

RECEIVED

DRILLERS REMARKS:

If well telescopes please sketch and show depths.

GROUND LEVEL

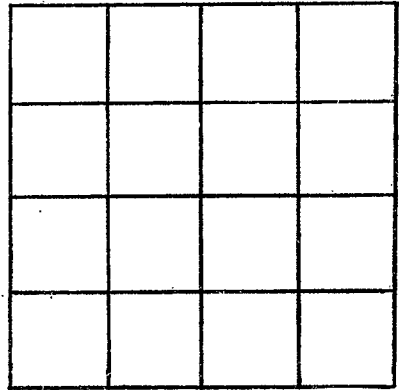

SECTION _____

Please indicate well location X.

ADDITIONAL INFORMATION

If more than one screen,
show locations of each on sketch.