

MISSISSIPPI DEPARTMENT OF NATURAL RESOURCES

Bureau of Land and Water Resources

Southport Mall

P.O. Box 10631

Jackson, Mississippi 39209

WATER WELL DRILLERS LOG

Lowndes
D
2011

7-15-83 date well completed 1983 Clardy Well Drilling Lowndes firm name county well located

LANDOWNER: Leon Taylor
Rt 2
Caledonia, Miss.
(mailing address)

WELL LOCATION:
sec. 4 T 17 N R 19 E
6 miles NE of Colo.
(distance) (direction) (nearest town)

WELL PURPOSE: home
(home, irrigation, municipal, industrial)

WELL COMPLETION DATA:

- (1) diameter (inches) 4"
- (2) total depth (feet) 202'
- (3) static water level (feet) 78' below top of ground.
- (4) casing PVC, 156'
(material) (depth)
4" if telescope see back.
(size)
- (5) screen 30'
(length) (depth to top)
2" PVC
(size) (material)
- (6) pump 1/2 2900 gph.
(HP) (yield gpm)
elec
(type power)
- (7) electric log No.
(yes or no)

(organization running log)

description of formations encountered	from	to
red. clay	0	10
gravel	10	23
blue clay	23	33
brown sandy clay	33	41
sandy blue clay	41	57
rock	57	57 1/2
good blue clay	57 1/2	64
rock	64	66 1/2
good blue clay	66 1/2	68
brown clay	68	75
rock 3"		
brown clay	75	85
sandy blue clay	85	87
hard blue clay	87	95
sandy clay	95	105
hard blue clay	105	113
sand	113	125
rock	125	125 1/2
blue clay	125 1/2	129
black clay	129	132
blue clay	132	134
rock 6 1/2"	134	
brown clay	134	138
grey clay	138	146
brown clay	146	152
grey clay	152	158
sandy clay	158	175
sand	175	185
sandy clay	185	190
good sand	190	199
hard clay	199	202

DEPT. OF NATURAL RESOURCES
BUREAU OF LAND & WATER RESOURCES

AUG 22 1983

RECEIVED

DRILLERS REMARKS:


If well telescopes please sketch and show depths.

GROUND LEVEL

156' - 4"

36' - 2"

30' screen

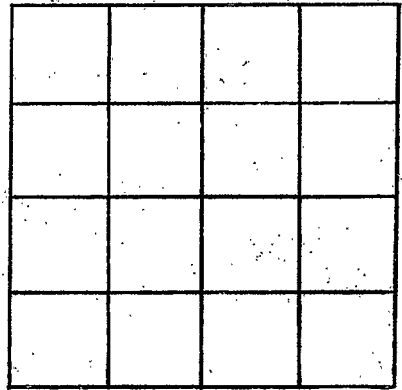

SECTION _____

Please indicate well location X.

ADDITIONAL INFORMATION

If more than one screen, show locations of each on sketch.