

Lanier
D
200

MISSISSIPPI
 BOARD OF WATER COMMISSIONERS
 416 North State Street
 Jackson, Mississippi 39201

WATER WELL DRILLERS LOG

May 30 1984 Mid South Drilling Company Lowndes
 date well completed firm name county well located

LANDOWNER: Contracted:	description of formations encountered	from	to
O.C. Electric	clay	0	9
2002 4th Ave. North	sand	9	26
Columbus, MS 39701	clay	26	90
(mailing address)	clay and sand	90	105
WELL LOCATION:			
sec <u>29</u> T <u>175</u> N R <u>17</u> E			
<u>1</u> miles <u>N</u> of <u>Col.</u>			
(distance) (direction) of (nearest town)			
WELL PURPOSE: <u>home</u>			
(home, irrigation, municipal, industrial)			
WELL COMPLETION DATA:			
(1) diameter (inches) <u>4"</u>			
(2) total depth (feet) <u>195'</u>			
(3) static water level (feet) <u>30</u> below surface			
top of ground.			
(4) casing <u>PVC</u> <u>105'</u>			
(material) (depth)			
<u>4"</u> If telescope see back.			
(size)			
(5) screen <u>none</u>			
(length) (depth to top)			
(size) (material)			
(6) pump <u>none</u>			
(HP) (yield gpm)			
(type power)			
(7) electric log <u>no</u>			
(yes or no)			
<u>no</u>			
(organization running log)			
(8) how well bottom plugged <u>open</u>			
DRILLERS REMARKS:			


DEPT. OF NATURAL RESOURCES
 BUREAU OF LAND & WATER RESOURCES

JUN 19 1984

RECEIVED

If well telescopes please sketch and show depths.

GROUND LEVEL

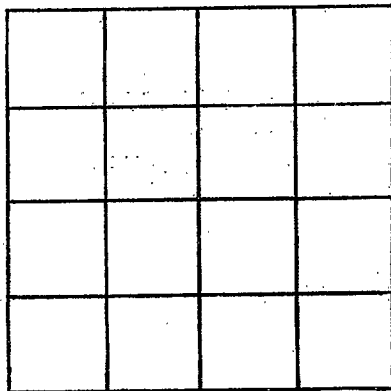

SECTION _____

Please indicate well location X.

ADDITIONAL INFORMATION

If more than one screen, show locations of each on sketch.