

MISSISSIPPI DEPARTMENT OF NATURAL RESOURCES

Bureau of Land and Water Resources

Southport Mall

P.O. Box 10631

Jackson, Mississippi 39209

WATER WELL DRILLERS LOG

LOWNDES  
D 2013

6-18-84 19 Clardy Wood Drilling Lowndes  
date well completed firm name county well located

LANDOWNER: Mr. Jaggart  
Rt 1 Box 463-A  
Steens, MS 39766  
(mailing address)

WELL LOCATION:  
sec. 34 T. 17 N. R. 17 E  
6 miles NE of Calo.  
(distance) (direction) (nearest town)

WELL PURPOSE: Home  
(home, irrigation, municipal, industrial)

- WELL COMPLETION DATA:
- (1) diameter (inches) 4"
  - (2) total depth (feet) 230
  - (3) static water level (feet) 100' below above top of ground.
  - (4) casing PVC, 152'  
(material) (depth)  
4"  
(size) If telescope see back.
  - (5) screen 20'  
(length) (depth to top)  
2" PVC  
(size) (material)
  - (6) pump 1/2 800 gpm  
(HP) (yield gpm)  
elec  
(type power)
  - (7) electric log No  
(yes or no)  
  
(organization running log)
  - (8) how well bottom plugged

description of formations encountered	from	to
red clay	0	13
sand & gravel	13	21
sand, red clay	21	27
shale clay	27	71
sandy clay	71	78
sand	78	81
sandy clay	81	95
rock 2"		
hard blue clay	95	126
green clay	126	143
sand	143	148
good clay	148	167
sand	167	189
brown clay	189	210
good sand	210	228
clay	228	230

DEPT. OF NATURAL RESOURCES  
BUREAU OF LAND & WATER RESOURCES


JUL 11 1984

RECEIVED


DRILLERS REMARKS:

If well telescopes please sketch and show depths.

GROUND LEVEL

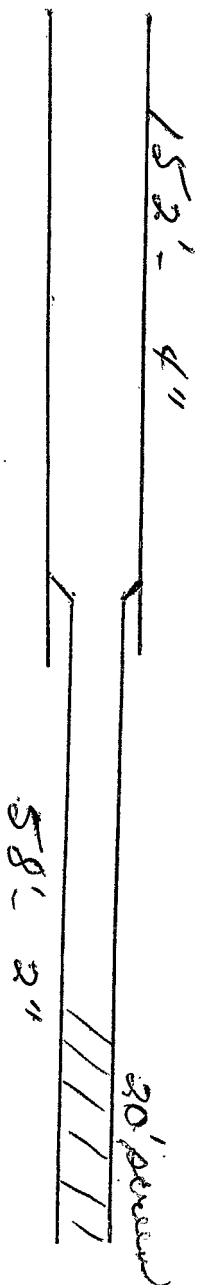

If more than one screen, show locations of each on sketch.

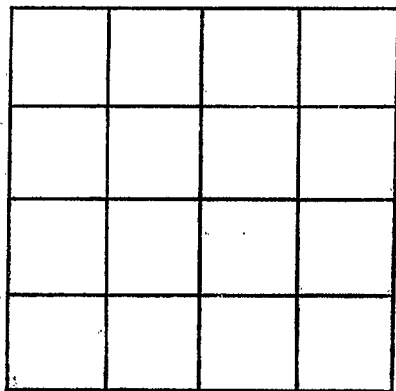

SECTION \_\_\_\_\_

Please indicate well location X.

ADDITIONAL INFORMATION

Lined area for additional information.