

Lounises
D
2014

MISSISSIPPI
 BOARD OF WATER COMMISSIONERS
 416 North State Street
 Jackson, Mississippi 39201

WATER WELL DRILLERS LOG

7-20 1989 Marion S. Robinson Lounises
 date well completed firm name county well located

LANDOWNER: <u>Steve Younger</u>	description of formations encountered	from	to
<u>Steens Well</u>			
(mailing address)	<u>sandy clay</u>	<u>0</u>	<u>12</u>
WELL LOCATION: sec <u>34</u> T <u>17</u> N R <u>17</u> E <u>3</u> miles <u>SE</u> of <u>Steens</u> (distance) (direction) (nearest town)	<u>gravel</u>	<u>12</u>	<u>18</u>
WELL PURPOSE: <u>none</u> (home, irrigation, municipal, industrial)	<u>bank & brick</u>	<u>18</u>	<u>148'</u>
WELL COMPLETION DATA:	<u>clay streaks</u>	<u>148</u>	<u>200</u>
(1) diameter (inches) <u>4"</u>	<u>clay streaks</u>		
(2) total depth (feet) <u>200'</u>			
(3) static water level (feet) <u>80</u> below above top of ground.			
(4) casing <u>PVC</u> , <u>148'</u> (material) (depth)			
(size) if telescope see back.			
(5) screen <u>none</u> (length) (depth to top)			
(size) (material)			
(6) pump <u>none</u> (HP) (yield gpm)			
(type power)			
(7) electric log (yes or no)			
(organization running log)			
(8) how well bottom plugged <u>open</u>			

DEPT. OF NATURAL RESOURCES
 BUREAU OF LAND & WATER RESOURCES


AUG 30 1984

RECEIVED

DRILLERS REMARKS:

If well telescopes please sketch and show depths.

GROUND LEVEL

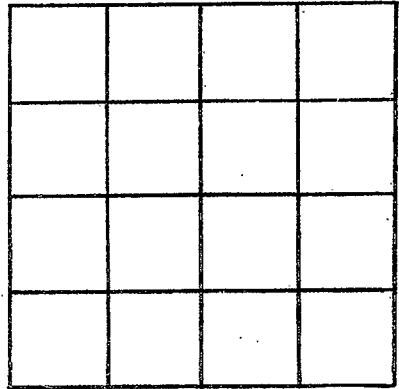

SECTION _____

Please indicate well location X.

ADDITIONAL INFORMATION

If more than one screen,
show locations of each on sketch.