

**MISSISSIPPI DEPARTMENT OF NATURAL RESOURCES**  
**Bureau of Land and Water Resources**  
 Southport Mall  
 P.O. Box 10631  
 Jackson, Mississippi 39209  
**WATER WELL DRILLERS LOG**

Lowndes

D 2015

6-13-85

6-13-85<sup>19</sup>  
 date well completed

Clardy Well Drilling Lowndes  
 firm name

county well located

LANDOWNER: Paul Thorne

description of formations encountered

from

to

1524 Shepherd Rd.

<u>blue clay</u>	<u>0</u>	<u>19</u>
<u>Coal</u>	<u>19</u>	<u>60</u>
<u>brown clay</u>	<u>60</u>	<u>61</u>
<u>blue clay</u>	<u>61</u>	<u>66</u>
<u>brown clay</u>	<u>66</u>	<u>68</u>
<u>soft blue clay</u>	<u>68</u>	<u>76 1/2</u>
<u>strata of blue clay</u>	<u>76 1/2</u>	<u>77</u>
<u>rock 6"</u>	<u>77</u>	<u>80</u>
<u>soft clay</u>	<u>80</u>	<u>81 1/2</u>
<u>rock</u>	<u>81 1/2</u>	<u>84</u>
<u>soft blue clay</u>	<u>84</u>	<u>97</u>
<u>soft blue clay</u>	<u>97</u>	<u>97 1/2</u>
<u>fine clay</u>	<u>97 1/2</u>	<u>102 1/2</u>
<u>soft clay</u>	<u>102 1/2</u>	<u>111 1/2</u>
<u>rock</u>	<u>111 1/2</u>	<u>119</u>
<u>sandy clay</u>	<u>119</u>	<u>120</u>
<u>sand</u>	<u>120</u>	<u>122</u>
<u>soft clay</u>	<u>122</u>	<u>127</u>
<u>rock</u>	<u>127</u>	<u>127</u>
<u>sand</u>	<u>127</u>	<u>128</u>
<u>soft blue clay</u>	<u>128</u>	<u>140</u>
<u>red clay</u>	<u>140</u>	<u>193</u>
<u>fine sand</u>	<u>193</u>	<u>198</u>
<u>good sand &amp; gravel</u>	<u>198</u>	<u>122</u>

(mailing address)


WELL LOCATION:

sec. 36 T. 17 N. R. 17 E  
8 miles NE of Cola  
 (distance) (direction) (nearest town)

WELL PURPOSE: home  
 (home, irrigation, municipal, industrial)

WELL COMPLETION DATA:

- diameter (inches) 4"
- total depth (feet) 322'
- static water level (feet) \_\_\_\_\_ below above top of ground.
- casing PVC (material), 180' (depth), 4" (size) if telescope see back.
- screen 20' (length), \_\_\_\_\_ (depth to top), 2" (size), PVC (material)
- pump \_\_\_\_\_ (HP), \_\_\_\_\_ (yield gpm)  
 (type power) \_\_\_\_\_
- electric log \_\_\_\_\_ (yes or no)  
 (organization running log) \_\_\_\_\_
- how well bottom plugged \_\_\_\_\_

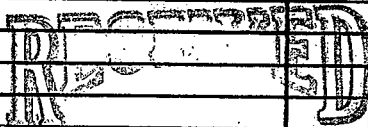

AUG - 9 1985

DRILLERS REMARKS:

Department of Natural Resources  
 Bureau of Land & Water Resources

