

MISSISSIPPI DEPARTMENT OF NATURAL RESOURCES

Bureau of Land and Water Resources

Southport Mall

P.O. Box 10631

Jackson, Mississippi 39209

WATER WELL DRILLERS LOG

NUMBERS
D.
2016

4/2/86 19 Clardy Well Drilling Lowndes
date well completed firm name county well located

LANDOWNER: Alvie Jordan
Steens, Miss.
(mailing address)

WELL LOCATION:
sec 30 T 17 N 6 R 17 E W
3 miles NE of Col
(distance) (direction) (nearest town)

WELL PURPOSE: farm
(home, irrigation, municipal, industrial)

- WELL COMPLETION DATA:
- (1) diameter (inches) 4"
 - (2) total depth (feet) 86 1/2'
 - (3) static water level (feet) 12' below above top of ground.
 - (4) casing PVC, 23',
(material) (depth)
4" if telescope see back.
(size)
 - (5) screen _____
(length) (depth to top)
(size) (material)
 - (6) pump _____
(HP) (yield gpm)
(type power)
 - (7) electric log _____
(yes or no)
(organization running log)
 - (8) how well bottom plugged _____

description of formations encountered	from	to
sand & gravel	0	21
clay	31	30
soft clay	30	39
clay	39	40
soft clay	40	44
rock		
clay	44	49 1/2
sandy streaks	49 1/2	51 1/2
clay	51 1/2	57 1/2
sandy clay	57 1/2	66 1/2
sandy streak	66 1/2	67
clay	67	68
rock	68	69
red clay	69	81
white clay	81	86 1/2


RECEIVED
MAY 22 1986

Department of Natural Resources
Bureau of Land and Water Resources

DRILLERS REMARKS:

If well telescopes please
sketch and show depths.

GROUND LEVEL

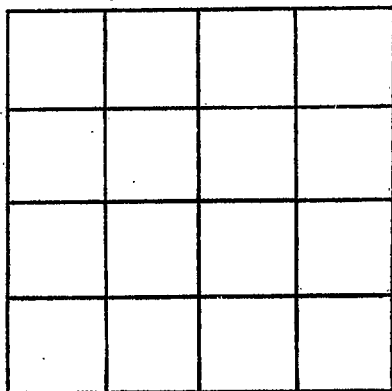

SECTION _____

Please indicate well location X.

ADDITIONAL INFORMATION

If more than one screen,
show locations of each on sketch.