

HOWDES  
 D 2017

MISSISSIPPI DEPARTMENT OF NATURAL RESOURCES  
 Bureau of Land and Water Resources  
 Southport Mall  
 P.O. Box 10631  
 Jackson, Mississippi 39209  
 WATER WELL DRILLERS LOG

6/12/26, Clardy Well Drilling Howdes  
 date well completed firm name county well located

LANDOWNER: S. Blackston  
 P.O. Box 62  
 Steens, MS 39766  
 (mailing address)

WELL LOCATION:  
 sec. 21 T. 17 N. R. 17 E.  
 1/4 miles NE of Calhoun  
 (distance) (direction) (nearest town)

WELL PURPOSE: home  
 (home, irrigation, municipal, industrial)

- WELL COMPLETION DATA:
- (1) diameter (inches) 4"
  - (2) total depth (feet) 142'
  - (3) static water level (feet) 18' below top of ground.
  - (4) casing PVC 63' (material) (depth)  
4" (size) if telescope see back.
  - (5) screen (length) (depth to top)  
(size) (material)
  - (6) pump 1/2 HP 900 gph. (HP) (yield gpm)  
elec. (type power)
  - (7) electric log no (yes or no)  
(organization running log)
  - (8) how well bottom plugged

description of formations encountered	from	to
Brown, Clay	0	7
Sand & gravel	7	17
Blue Clay	17	92
Sandy streaks	92	101
Sand	101	110
Clay	110	127
Sand	127	133
Hard Clay	133	140
White Clay	140	142


RECEIVED  
 AUG 01 1986

Department of Natural Resources  
 Bureau of Land and Water Resources

DRILLERS REMARKS:

If well telescopes please sketch and show depths.

GROUND LEVEL

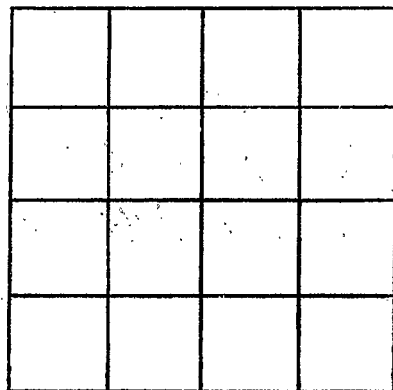

SECTION \_\_\_\_\_

Please indicate well location X.

ADDITIONAL INFORMATION

If more than one screen,  
show locations of each on sketch.