

MISSISSIPPI DEPARTMENT OF NATURAL RESOURCES
Bureau of Land and Water Resources

P.O. Box 10631
Jackson, Mississippi 39209
'WATER WELL DRILLERS LOG

COUNTY WELL LOCATED <u>Monroe</u>	
WELL NUMBER <u>D 2020</u>	CODED
DATE WELL COMPLETED <u>9/22/87</u>	

PERMIT NUMBER
NAME OF DRILLING FIRM <u>Clardy Well Drill</u> <u>Columbia, Mo</u>

NAME & MAILING ADDRESS OF LANDOWNER <u>Albert Glenn</u> <u>1968 Pomona</u> <u>Memphis, Mo. 38116</u>			
WELL LOCATION:	SEC	TOWNSHIP	RANGE
	<u>6</u>	<u>17</u> ^N	<u>17</u> ^W
DISTANCE	DIRECTION	NEAREST TOWN	
<u>4</u> Miles	<u>S.W.</u>	of <u>Colodonia</u>	
OTHER LANDMARK			
WELL PURPOSE: Home, Irrigation, Municipal, Industrial, Fish Pond, etc. <u>Home</u>			

PUMP DATA		
PUMP TYPE (Circle One): <u>Submersible</u> , Turbine, Jet, Flowing Well, Other (Describe) _____		
POWER TYPE (Circle One): <u>Electric</u> , Tractor, Diesel, Gasoline, Butane, Other (Describe) _____		
Pump Capacity (GPM) <u>900</u>	No. of Stages <u>10</u>	Setting Depth <u>100</u> FT.
PUMP TEST Well yielded <u>900</u> GPM with a drawdown of _____ ft. after _____ hours of pumping		

WELL DATA		
Well Depth <u>193'</u>	Casing Diameter (In.) <u>4"</u>	Casing Length (Ft.) <u>150'</u>
Type of Casing <u>PVC</u>	Hole Depth	Depth to Static Water Level <u>56 1/2'</u>
TYPE OF COMPLETION: (Circle One or More): Gravel Packed, Underreamed, <u>Telescoped</u> , Natural Development, Open Hole, Other		
Top of Lap Pipe or Reduction in Casing FEET IF TELESCOPED OR MORE THAN ONE SCREEN: USE BACK PAGE		

LOG DATA	
TYPE OF LOG RUN (Circle One): Electric, Gamma Ray, Density, Sonic, <u>No Log Run</u> , Other (Describe) _____	
Name of Organization Running Log	

SCREEN DATA		
Diameter - Inches <u>2"</u>	Length - Feet <u>40</u>	Slot Size - Inches <u>.013</u>
Screen Type <u>PVC</u>	Depth to Bottom - Feet	


GEOLOGIC DATA (Office Use Only)			
Surface Elev. _____	Geologic Unit _____	Well Thickness _____	Depth to Top _____
Subs. SWL _____	Date _____	Analysis _____	Aquifer Test _____
Driller's Remarks <u>OCT 28 1987</u>			
Department of Natural Resources Bureau of Land & Water Resources			

DESCRIPTION OF FORMATIONS ENCOUNTERED	FROM	TO	FORMATIONS (Continued)	FROM	TO
Red sandy clay	0	15	White clay	121	139
sand + gravel	15	31	sand streak	139	140
Blue clay	31	42	sandy blue clay	140	148
sandy blue clay	42	94	Blue clay	148	150
Blue clay	94	98	sandy clay	150	153
White sandy clay	98	105	Blue clay	153	154
Blue clay	105	107	sandy blue clay	154	164
Small rock	107		sand streak	164	165
Blue clay	107	116	sandy clay	165	167
Brown clay	116	119	sand	167	177
Blue clay	119	121			

IF MORE SPACE IS NEEDED, USE BACK

If well telescopes please sketch and show depths.

GROUND LEVEL

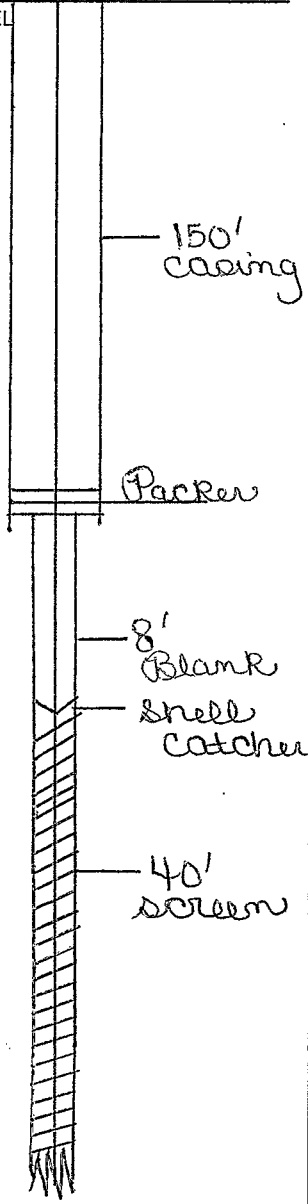

SECTION _____

Please indicate well location X.

ADDITIONAL INFORMATION

sand streak	177-181
sandy clay	181-187
sand streak	187-192
White clay	192-193

If more than one screen, show location of each on sketch.