

MISSISSIPPI DEPARTMENT OF ENVIRONMENTAL QUALITY

Office of Land and Water Resources

P. O. Box 10631
Jackson, MS 39289-0631

WATER WELL DRILLERS LOG

COUNTY WELL LOCATED
Lowndes

WELL NUMBER 6289 CODED

PERMIT NUMBER

NAME OF DRILLING FIRM
Mid-South Drilling Co.

Carrollton, AL

D-2035
DATE WELL COMPLETED
5/1/02

NAME & MAILING ADDRESS OF LANDOWNER

Douglas Hill
456 Fernbank Rd.
Steens, MS 39766

Latitude:
Longitude:

WELL LOCATION SEC TOWNSHIP RANGE

23 17 N 17 W

DISTANCE DIRECTION NEAREST TOWN
2 Miles ENE of Steens

OTHER LANDMARK

WELL PURPOSE: Home, Irrigation, Municipal, Industrial, Fish Pond, etc.
home

WELL DATA

Well Depth 163 Casing Diameter (In.) 4" & 2" Casing Length (Ft.) *see back*

Type of Casing PVC Hole Depth 163 Depth to Static Water Level 25

TYPE OF COMPLETION: (Circle One or More)
Gravel Packed, Underreamed, Telescoped,
Natural Development, Open Hole, Other
(Describe)

WELL GROUTED TO A DEPTH OF 10 FEET
Type Grout (circle one): Cement, Bentonite, or Mix

SCREEN DATA

Diameter - Inches 2 Length - Feet 40 Slot Size - Inches .014

Screen Type PVC Depth to Bottom - Feet 4'

PUMP DATA

PUMP TYPE (Circle One):
Submersible, Turbine, Jet, Flowing Well,
Other (Describe)

POWER TYPE (Circle One):
Electric, Tractor, Diesel, Gasoline, Butane,
Other (Describe) H/P

DESCRIPTION OF FORMATIONS ENCOUNTERED	FROM	TO
clay	0	012
sandy red clay & gravel	112	016
sand & gravel	016	023
blue clay	023	073
pale blue clay	073	097
clay w/sand streaks	097	120
sand	120	135
coarse sand	135	142
clay w/sand streaks	142	163

RECEIVED

MAY 06 2002

BY: OLWR

Top of Lap Pipe or Reduction in Casing

104 FEET IF TELESCOPED OR MORE THAN ONE SCREEN: USE BACK PAGE

I certify that the well was drilled, constructed and completed in accordance with all applicable Requirements of the Mississippi Department of Environmental Quality and/or the Mississippi Department of Health regulations and state laws.


Ronald C. Brown 0-154
Signature of Licensed Driller and License No.

5-2-02
Date

Additional Information Required On Back

If well telescopes please sketch and show depths.

GROUND LEVEL

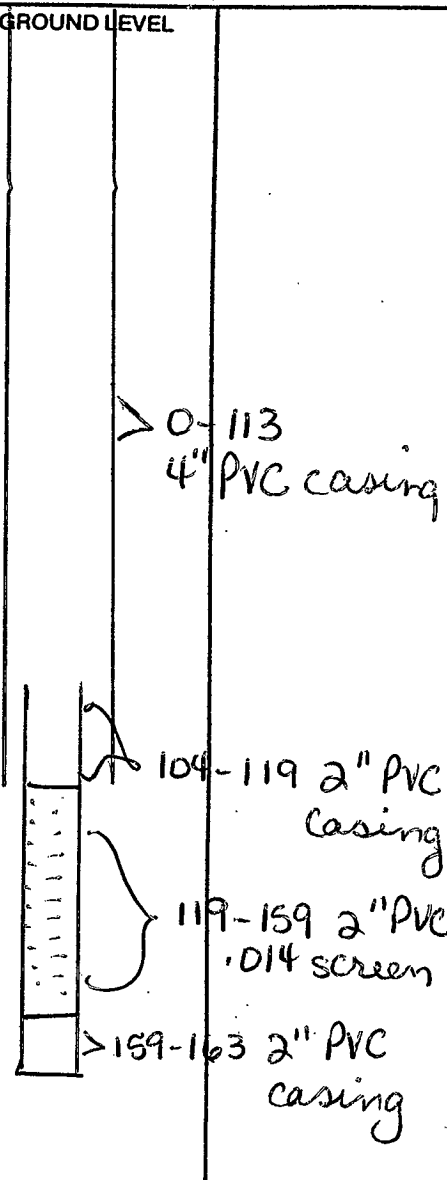

SECTION _____

Please indicate well location X.

Pump Capacity (GPM)	No. of Stages	Setting Depth	FT.
PUMP TEST			
Well yielded _____ GPM with			
a drawdown of _____ ft.			
after _____ hours of pumping			

LOG DATA

TYPE OF LOG RUN (Circle One):	No Log Run,
Electric, Gamma Ray, Density, Sonic, Neutron,	
Other (Describe) _____	
Name of Organization Running Log	

GEOLOGIC DATA (Office Use Only)

Surface Elev.	Geologic Unit	Unit Thickness	Depth to Top
Subs. SWL	Date	Analysis	Aquifer Test

Driener's Remarks

If more than one screen, show location of each on sketch.