

Lowndes  
E  
~~Lowndes~~

MISSISSIPPI  
 BOARD OF WATER COMMISSIONERS  
 416 North State Street  
 Jackson, Mississippi 39201

WATER WELL DRILLERS LOG

August 14 1984 Mid South Drilling Company Lowndes  
 date well completed firm name county well located


LANDOWNER: Contractor	description of formations encountered	from	to
O. C. Electric			
2002 4th Ave. N.	clay	0	180
Columbus, MS 39701	clay and sand	180	315
(mailing address)			
<b>WELL LOCATION:</b>			
sec. <u>13</u> T. <u>18</u> N. R. <u>16</u> E			
4 miles north of Columbus			
(distance) (direction) (nearest town)			
<b>WELL PURPOSE:</b> home			
(home, irrigation, municipal, industrial)			
<b>WELL COMPLETION DATA:</b>			
(1) diameter (inches) <u>4"</u>			
(2) total depth (feet) <u>315'</u>			
(3) static water level (feet) _____ below top of ground. above			
(4) casing <u>PVC</u> , <u>250'</u>			
(material) (depth)			
<u>4"</u> if telescope see back.			
(size)			
(5) screen <u>60'</u> , <u>250</u>			
(length) (depth to top)			
<u>2"</u> , <u>PVC</u>			
(size) (material)			
(6) pump <u>none</u> _____			
(HP) (yield gpm)			
(type power)			
(7) electric log <u>no</u>			
(yes or no)			
<u>no</u>			
(organization running log)			
(8) how well bottom plugged <u>screened</u>			
<b>DRILLERS REMARKS:</b>			

DEPT. OF NATURAL RESOURCES  
 BUREAU OF LAND & WATER RESOURCES

AUG 16 1984  
 RECEIVED

If well telescopes please sketch and show depths.

GROUND LEVEL

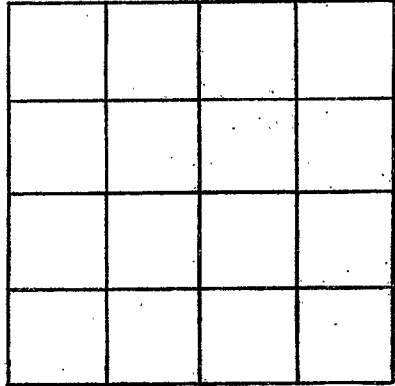

SECTION \_\_\_\_\_

Please indicate well location X.

ADDITIONAL INFORMATION

If more than one screen, show locations of each on sketch.