

Lowndes
E 16
8-71

MISSISSIPPI
BOARD OF WATER COMMISSIONERS
416 North State Street
Jackson, Mississippi 39201
WATER WELL DRILLERS LOG

CODED

CODED

date well completed 1971 Weg
HERMAN ECHOLS
Pump & Well Service
Starkville, Miss.
county well located Lowndes




LANDOWNER:
John Gordon Fort
Columbus, Miss
(mailing address)

Stratigraphic formations encountered	from	to
<u>Black Soil</u>	<u>0</u>	<u>10</u>
<u>(Chalk)</u>	<u>10</u>	<u>226</u>
<u>Sand with 40' Sp. a.</u> <u>(Chalk lens)</u>	<u>226</u>	<u>425</u>

WELL LOCATION:
sec 21 T 19 N R 16 E
S W
1 miles South of Wynnew
(distance) (direction) (nearest town)

WELL PURPOSE: Farm
(home, irrigation, municipal, industrial)

- WELL COMPLETION DATA:
- diameter (inches) 5 1/2
 - total depth (feet) 425
 - static water level (feet) 50 below above top of ground.
 - casing 2 1/2 5 1/2
(material) (depth)
(size) if telescope see back.
 - screen 100' Slotted pipe
(length) (depth to top)
(size) (material)
 - pump 3/4 15
(HP) (yield gpm)
Elm.
(type power)
 - electric log (yes or no) _____
(organization running log) _____
 - how well bottom plugged _____

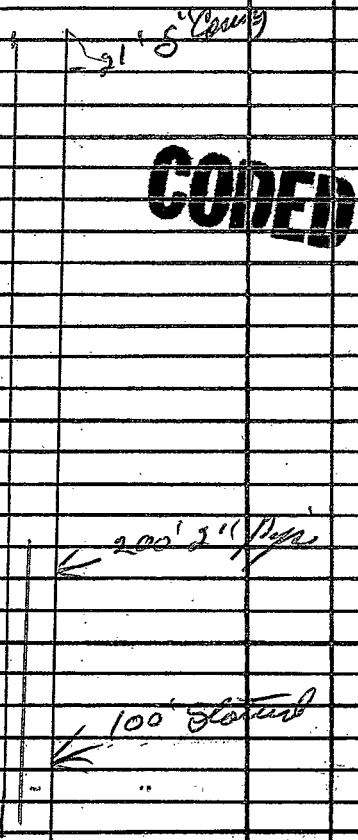

CODED

DRILLERS REMARKS: _____

OCT 11 1971

If well telescopes please sketch and show depths.

GROUND LEVEL

SECTION _____

Please indicate well location X.

ADDITIONAL INFORMATION

If more than one screen,
show locations of each on sketch.