

LOWNDES

E20

10-5-73

MISSISSIPPI BOARD OF WATER COMMISSIONERS  
416 North State Street  
Jackson, Mississippi 39201

CODED

WATER WELL DRILLERS LOG

10/5  
date well completed

1973

Norman E. Ebb  
firm name

Township  
county well located


LANDOWNER:	description of formations encountered	from	to
Stores Opview Meyhan, Miss (mailing address)			

WELL LOCATION:  
sec 29 T 14 N R 16 E  
S W  
12 miles West of Columbus  
(distance) (direction) (nearest town)

WELL PURPOSE: 10 Power  
(home, irrigation, municipal, industrial)

CODED

- WELL COMPLETION DATA:
- (1) diameter (inches) 5"
  - (2) total depth (feet) 460
  - (3) static water level (feet) 60 below top of ground.
  - (4) casing 2 1/2" 5" Top (material), (depth)  
2 5/8" 2 1/2" Rotten (size) if telescope see back.
  - (5) screen 0 (length), (depth to top)  
(size) (material)
  - (6) pump 3/4 (HP) 10 (yield gpm)  
Elex (type power)
  - (7) electric log (yes or no)  
(organization running log)
  - (8) how well bottom plugged

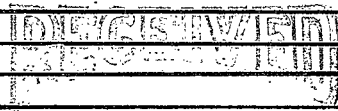

JAN 7 1974

DRILLERS REMARKS:

over

If well telescopes please sketch and show depths.

GROUND LEVEL

2' 5" casing



Chalk

Total 2 1/2" pipe  
252'

Sand

Sand

Dark clay

Dark clay

Sand

Sand

40' SLOTTED PIPE  
ALL SLOTTED PIPE

H60

			X

SECTION 29

Please indicate well location X.

ADDITIONAL INFORMATION

If more than one screen, show locations of each on sketch.