

LOWMEDES
E21
3-7-74

MISSISSIPPI
BOARD OF WATER COMMISSIONERS
416 North State Street
Jackson, Mississippi 39201

CODED
LOWMEDES

WATER WELL DRILLERS LOG

3/7 1974 *Norman Echols* firm name *Frank* county well located

LANDOWNER: *Bobby Fort*
Mayhew, Miss
(mailing address)
WELL LOCATION:
sec *24* T *14* N S R *16* E W
1 miles *E* of *Mayhew*
(distance) (direction) (nearest town)

description of formations encountered	from	to
<i>Red clay</i>	<i>0</i>	<i>5</i>
<i>Chalk</i>	<i>5</i>	<i>350</i>
<i>Small clay</i>	<i>300</i>	<i>400</i>
<i>Slur</i>	<i>400</i>	<i>500</i>
<i>21' 5" Top casing</i>		

WELL PURPOSE: *Home*
(home, irrigation, municipal, industrial)

WELL COMPLETION DATA:
(1) diameter (inches) *5"*
(2) total depth (feet) *500*
(3) static water level (feet) *80* below above top of ground.
(4) casing *21' 5" STUB*
(material) (depth)
(size) if telescope see back.
(5) screen _____
(length) (depth to top)
(size) (material)
(6) pump *3/4* *10*
(HP) (yield gpm)
FLFC
(type power)
(7) electric log _____
(yes or no)
(organization running log)
(8) how well bottom plugged _____

CODED		
	<i>200</i>	
	<i>231'</i>	
<i>SLOTTED Pipe</i>		
<i>Bottom</i>		
	<i>400</i>	
	<i>231' 1/2</i>	


DRILLERS REMARKS:

RECEIVED
JUL 26 1974

MISS. BD. OF WATER COMMISSIONERS

If well telescopes please sketch and show depths.

GROUND LEVEL

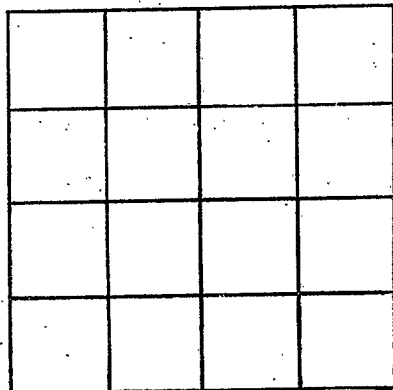

SECTION _____

Please indicate well location X.

ADDITIONAL INFORMATION

If more than one screen, show locations of each on sketch.