

LOWNDES
E 22
7-25-74

MISSISSIPPI
 BOARD OF WATER COMMISSIONERS
 416 North State Street
 Jackson, Mississippi 39201

CODED

WATER WELL DRILLERS LOG

HERNAN ECHOLS

July 25 1974 ~~TC Billups~~ firm name LOWNDES county well located

LANDOWNER: TC Billups
ARTESIA, MISS
RFD
 (mailing address)
 WELL LOCATION:
 sec. 14 T. 19 (N) S R. 16 (E) W
3 miles E of ARTESIA
 (distance) (direction) (nearest town)

description of formations encountered	from	to
Clay	0	15
Chalk	15	360
Sand & Rock	360	500

CODED

WELL PURPOSE:
 (home) Irrigation, municipal, industrial

- WELL COMPLETION DATA:
- (1) diameter (inches) 5"
 - (2) total depth (feet) 500
 - (3) static water level (feet) 80 below above top of ground.
 - (4) casing 2 1/2" 5"
 (material) (depth)
 (size) if telescope see back.
 - (5) screen _____
 (length) (depth to top)
 (size) (material)
 - (6) pump 1 1/2 15
 (HP) (yield gpm)
Elect.
 (type power)
 - (7) electric log (yes or no)
 (organization running log)
 - (8) how well bottom plugged _____

REGISTERED


DEC 29 1974

MISS. Bd. OF WATER COMMISSIONERS

DRILLERS REMARKS:

If well telescopes please sketch and show depths.

GROUND LEVEL

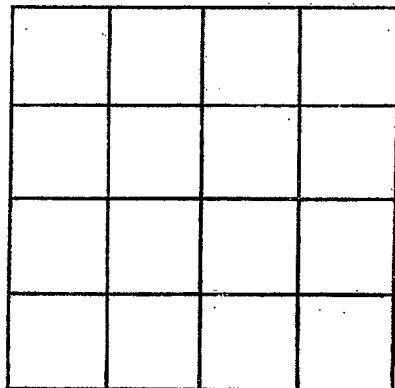

SECTION _____

Please indicate well location X.

ADDITIONAL INFORMATION

If more than one screen, show locations of each on sketch.