

LOWNDES  
E 23  
3-5-75

MISSISSIPPI  
BOARD OF WATER COMMISSIONERS  
416 North State Street  
Jackson, Mississippi 39201

CODED

WATER WELL DRILLERS LOG

3/5/1975 date well completed  
Norman Elch firm name  
Lowndes county well located

LANDOWNER: Nirby Mitchell  
R7D  
West point, Miss.  
(mailing address)

description of formations encountered	from	to
top Soil (Belt)	0	8
Clay	8	325
Sand	325	450

WELL LOCATION:  
sec. 19 T. 19N R. 16E  
S W  
6 miles South of West Point  
(distance) (direction) (nearest town)

WELL PURPOSE: Home  
(home, irrigation, municipal, industrial)

- WELL COMPLETION DATA:
- (1) diameter (inches) 5"
  - (2) total depth (feet) 450
  - (3) static water level (feet) 100 below above top of ground.
  - (4) casing 21' 5", Steel,  
(material) (depth)  
(size) if telescope see back.
  - (5) screen \_\_\_\_\_  
(length) (depth to top)  
(size) (material)
  - (6) pump 1/2 10  
(HP) (yield gpm)  
Electric  
(type power)
  - (7) electric log \_\_\_\_\_  
(yes or no)  
(organization running log)
  - (8) how well bottom plugged 0

RECEIVED


MAY 13 1975

DRILLERS REMARKS:  
Test Well with air Comp.  
Yield 75 GPM

MISS. BD. OF WATER COMMISSIONERS

If well telescopes please sketch and show depths.

GROUND LEVEL

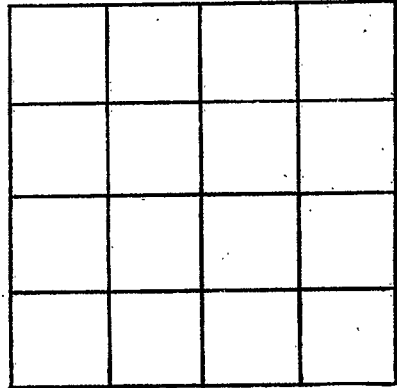

SECTION \_\_\_\_\_

Please indicate well location X.

ADDITIONAL INFORMATION

If more than one screen, show locations of each on sketch.