

LOWMEDES
E 24
4-25-75

MISSISSIPPI
 BOARD OF WATER COMMISSIONERS
 416 North State Street
 Jackson, Mississippi 39201

CODED

WATER WELL DRILLERS LOG

Landown

4/25 1975
 date well completed

Norman Echols
 firm name

Landown
 county well located

LANDOWNER: *Benneth Jones*

description of formations encountered

from to

Turney, Miss. Phone 878-596

Red Clay & Sand

0 12

Myrtle Miss
 (mailing address)

Wash Sand

12 260
 260 400

WELL LOCATION: *Myrtle Miss*

sec. 21 T. 19 N. R. 10 E. S. 5

12 miles *West* of *Columbus*
 (distance) (direction) (nearest town)

WELL PURPOSE: *Home*
 (home, irrigation, municipal, industrial)

WELL COMPLETION DATA:

- (1) diameter (inches) *5"*
- (2) total depth (feet) *400*
- (3) static water level (feet) *90* above top of ground.

(4) casing *2 1/2" 5"* casing
 (material) (depth)

(size) If telescope see back.

(5) screen (length) (depth to top)

(size) (material)

(6) pump *1/2* *106 PAA*
 (HP) (yield gpm)

6 kw
 (type power)

(7) electric log *no*
 (yes or no)

(organization running log) *O*

(8) how well bottom plugged *O*


2 1/2
50
130

RECEIVED
 MAY 19 1975

DRILLERS REMARKS:

If well telescopes please sketch and show depths.

GROUND LEVEL

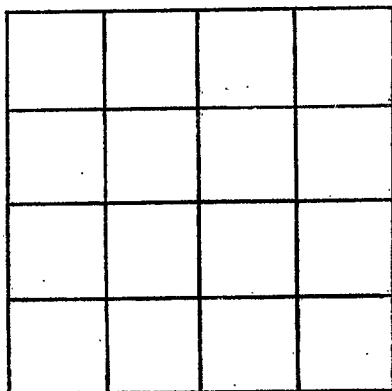

SECTION _____

Please indicate well location X.

ADDITIONAL INFORMATION

If more than one screen, show locations of each on sketch.