

**LOWNDES**  
**E 26**  
**11-1-81**  
**E log # 91**  
**11-1-81**

MISSISSIPPI  
 BOARD OF WATER COMMISSIONERS  
 416 North State Street  
 Jackson, Mississippi 39201  
 MS-LW-01294  
**WATER WELL DRILLERS LOG**

**CODED**

**J. W. Webb & SONS** **Lowndes**  
 firm name county well located

**LANDOWNER:**

**G. T. WATER ASSOCIATION**  
**West Point, Miss**  
 (mailing address)

**WELL LOCATION:**

sec. 30 T. 19N S. R. 16E W.  
9 miles S of West Point  
 (distance) (direction) (nearest town)

**WELL PURPOSE:** COMMUNITY  
 (home, irrigation, municipal, industrial)

**WELL COMPLETION DATA:**

- (1) diameter (inches) 10"
- (2) total depth (feet) 456
- (3) static water level (feet) 112 <sup>below</sup>/<sub>above</sub> top of ground.
- (4) casing Steel 395  
 (material) (depth)  
 (size) if telescope see back.
- (5) screen 166' 362  
 (length) (depth to top)  
6" S.S.  
 (size) (material)
- (6) pump 20 200  
 (HP) (yield gpm)  
Elec  
 (type power)
- (7) electric log yes  
 (yes or no)  
MISS. STATE COS.  
 (organization running log)
- (8) how well bottom plugged  
S. SKIN WASH VALVE

**description of formations encountered**

**from to**

Red CLAY	0	8'
Blue CLAY	8'	280'
Blue CLAY/SAND	280	310
Blue CLAY	310	350
SANDY Blue CLAY	350	400
SOFT Grey SAND	400	450
Blue CLAY	450	500

**CODED**

DEPT. OF NATURAL RESOURCES  
 BUREAU OF LAND & WATER RESOURCES

SEP - 9 1982


**RECEIVED**

**DRILLERS REMARKS:**

NO START

(X)

If well telescopes please sketch and show depths.

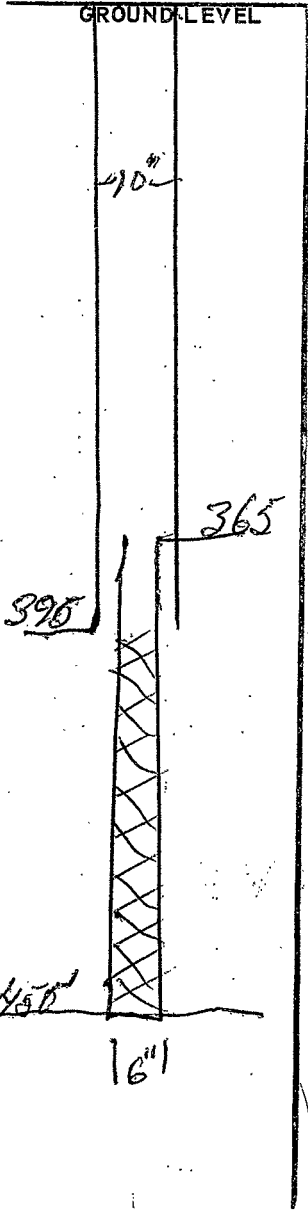


SECTION 30

Please indicate well location X.

ADDITIONAL INFORMATION


If more than one screen, show locations of each on sketch.