

LOWDOES  
WELL NO 1  
Will be 3 like this  
E 1001  
7/26/77

MISSISSIPPI  
BOARD OF WATER COMMISSIONERS  
416 North State Street  
Jackson, Mississippi 39201  
WATER WELL DRILLERS LOG

7/26 1977 HERMAN ELLIOTT'S Lauderdale  
date well completed firm name county well located

LANDOWNER: <u>KING RANCH</u> <u>RFD 82 West</u>	description of formations encountered from to
<u>Columbus, Miss</u> (mailing address)	
WELL LOCATION: <u>Sec 26 T 19 N R 16 E</u> <u>9</u> miles <u>East</u> of <u>Maubien</u> (distance) (direction) (nearest town)	<u>21 1/2" casing</u>
WELL PURPOSE: <u>Cattle</u> (home, irrigation, municipal, industrial)	
WELL COMPLETION DATA: (1) diameter (inches) <u>6</u> (2) total depth (feet) <u>420</u> (3) static water level (feet) _____ below/above top of ground. (4) casing <u>21 1/2" Steel</u> (material) (depth) <u>210' 4"</u> If telescope see back. (size) (5) screen _____ (length) (depth to top) (size) (material) (6) pump <u>25</u> (HP) (yield gpm) (type power) (7) electric log _____ (yes or no) (organization running log) (8) how well bottom plugged <u>0</u>	


**RECEIVED**  
AUG - 1 1977  
MISS. BD. OF WATER

DRILLERS REMARKS:

(X)

If well telescopes please sketch and show depths.

GROUND LEVEL

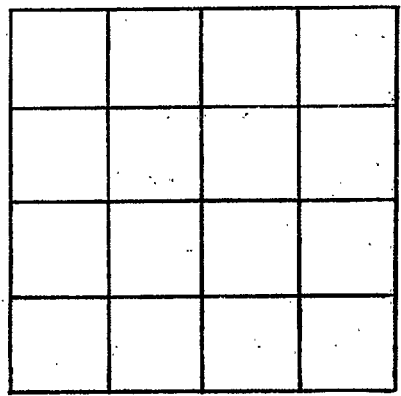

SECTION \_\_\_\_\_

Please indicate well location X.

ADDITIONAL INFORMATION

A series of horizontal lines providing space for additional information.

If more than one screen, show locations of each on sketch.