

Lowndes  
E 1002  
3-4-80

MISSISSIPPI  
 BOARD OF WATER COMMISSIONERS  
 416 North State Street  
 Jackson, Mississippi 39201


WATER WELL DRILLERS LOG

3-4-80 date well completed      80 Mid South Drilling firm name      Lowndes county well located

LANDOWNER: J.S. Phillips

Columbus, MS  
 (mailing address)

WELL LOCATION:

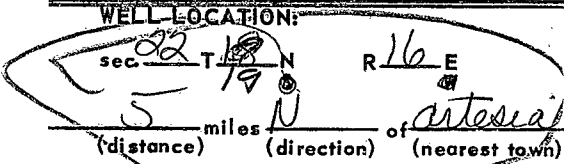

(distance) (direction) (nearest town)

WELL PURPOSE: home  
 (home, irrigation, municipal, industrial)

WELL COMPLETION DATA:

- (1) diameter (inches) 6#
- (2) total depth (feet) 525
- (3) static water level (feet) 60 below top of ground. above
- (4) casing pvc 40'  
 (material) (depth)  
 (size) if telescope see back.
- (5) screen no (length) (depth to top)  
 (size) (material)
- (6) pump 3/4 5  
 (HP) (yield gpm)  
electric  
 (type power)
- (7) electric log no  
 (yes or no)  
no  
 (organization running log)
- (8) how well bottom plugged open

description of formations encountered

from to

clay	0	141
sand	141	143
clay	143	180
clay & sand	180	195
clay	195	281
sand	281	285
clay & sand	285	295
sand	295	300
clay	300	307
sand	307	315
clay U sand	315	340
sand	340	390
<del>sand</del> clay	390	392
<del>sand</del>	392	400
clay	400	403
clay & Sand	403	510
clay	510	525

DEPT. OF NATURAL RESOURCES  
 BUREAU OF LAND & WATER RESOURCES

JUL - 2 1980

RECEIVED

DRILLERS REMARKS:

If well telescopes please sketch and show depths.

GROUND LEVEL


SECTION \_\_\_\_\_

Please indicate well location X.

ADDITIONAL INFORMATION

If more than one screen, show locations of each on sketch.