

Lowndes
E 2000
8-28-75

MISSISSIPPI
BOARD OF WATER COMMISSIONERS
416 North State Street
Jackson, Mississippi 39201

WATER WELL DRILLERS LOG

8/28/1975 *Norman E. Baker* *Lowndes*
date well completed firm name county well located

LANDOWNER:
Carter Equipment Co.
Columbus Miss
(mailing address)

description of formations encountered	from	to
<i>Clay Sand</i>	<i>0</i>	<i>20</i>
<i>Sand</i>	<i>20</i>	<i>400</i>

WELL LOCATION: *13L*
sec. *36* T. *19* (N) R. *16* (E)
9 miles *West* of *Columbus*
(distance) (direction) (nearest town)

WELL PURPOSE:
(home, irrigation, municipal, industrial)

WELL COMPLETION DATA:
(1) diameter (inches) *5*
(2) total depth (feet) *400*
(3) static water level (feet) *100* below above top of ground.
(4) casing *24" 5'* (material) (depth)
(size) if telescope see back.
(5) screen (length) (depth to top)
(size) (material)
(6) pump *1 10 @ 60 #* (HP) (yield gpm)
Electric (type power)
(7) electric log (yes or no)
(organization running log)
(8) how well bottom plugged


Note
2 1/2" pipe in Bottom
100' Slotted in Sand
3.0

DRILLERS REMARKS:

RECEIVED
NOV 12 1975
MISS. BD OF WATER COMMISSIONERS

If well telescopes please sketch and show depths.

GROUND LEVEL

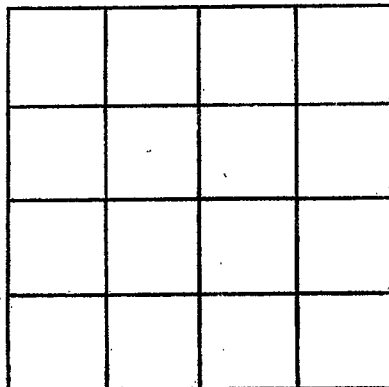

SECTION _____

Please indicate well location X.

ADDITIONAL INFORMATION

If more than one screen, show locations of each on sketch.