

Lowndes
E 2001
8/76

MISSISSIPPI
 BOARD OF WATER COMMISSIONERS
 416 North State Street
 Jackson, Mississippi 39201

WATER WELL DRILLERS LOG

Aug 1976 Foreman Ehol Lowndes
 date well completed firm name county well located

LANDOWNER: James M. Reynolds

description of formations encountered	from	to
<u>Clay</u>	<u>0</u>	<u>12</u>
<u>Chalk</u>	<u>12</u>	<u>212</u>
<u>Sand</u>	<u>212</u>	<u>350</u>

Steelville, Mo
 (mailing address)

WELL LOCATION:
 sec 13 T 19 N R 16 E
S W
8 miles West Columbus
 (distance) (direction) (nearest town)

WELL PURPOSE: Home
 (home, irrigation, municipal, industrial)

WELL COMPLETION DATA:

- (1) diameter (inches) 4 1/2
- (2) total depth (feet) 350
- (3) static water level (feet) 110 below above top of ground.
- (4) casing 21' 5" Steel
 (material) (depth)
 _____ if telescope see back.
 (size)
- (5) screen _____
 (length) (depth to top)
 (size) (material)
- (6) pump 1/2 10
 (HP) (yield gpm)
Elec.
 (type power)
- (7) electric log _____
 (yes or no)

 (organization running log)
- (8) how well bottom plugged 0


DRILLERS REMARKS:

RECEIVED
 SEP - 7 1976

MISS. BD. OF WATER COM.

If well telescopes please
sketch and show depths.

GROUND LEVEL

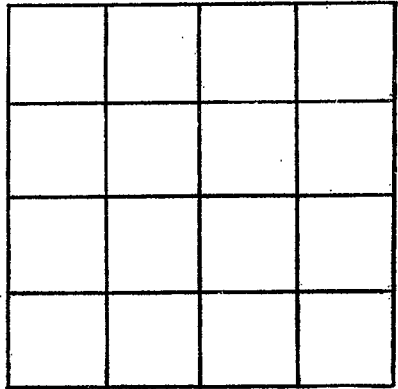

SECTION _____

Please indicate well location X.

ADDITIONAL INFORMATION

If more than one screen,
show locations of each on sketch.