

Lowder
E 2002
8/7/76

MISSISSIPPI
 BOARD OF WATER COMMISSIONERS
 416 North State Street
 Jackson, Mississippi 39201

WATER WELL DRILLERS LOG

Aug 7 1976 Norman E. Ebert Lowder
 date well completed firm name county well located

LANDOWNER:
L. B. Bland
Mayhem, Miss
 (mailing address)

| description of formations encountered | from | to |
|---------------------------------------|------------|------------|
| <u>Red clay</u> | <u>0</u> | <u>15</u> |
| <u>(Chalk)</u> | <u>15</u> | <u>330</u> |
| <u>Sand</u> | <u>330</u> | <u>460</u> |

WELL LOCATION:
 sec. 31 T 19 N R. 16 E
S W
4 miles north of Artesia
 (distance) (direction) (nearest town)

WELL PURPOSE: Home
 (home, irrigation, municipal, industrial)

- WELL COMPLETION DATA:
- (1) diameter (inches) 4 1/2
 - (2) total depth (feet) 460
 - (3) static water level (feet) 30 below top of ground.
 - (4) casing 21' 6" Plaster
 (material) (depth)
 _____ if telescope see back.
 (size)
 - (5) screen _____
 (length) (depth to top)


 (size) (material)
 - (6) pump 1/2 10
 (HP) (yield gpm)
E. Ebert
 (type power)
 - (7) electric log (yes or no)
 - _____ (organization running log)
 - (8) how well bottom plugged 0

DRILLERS REMARKS:

RECEIVED
 SEP - 7 1976
 MISS. BD. OF WATER COMMISSIONERS

If well telescopes please sketch and show depths.

GROUND LEVEL

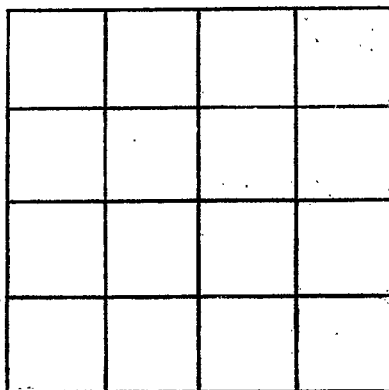

SECTION _____

Please indicate well location X.

ADDITIONAL INFORMATION

If more than one screen, show locations of each on sketch.