

MISSISSIPPI BOARD OF WATER COMMISSIONERS

LOWNDES

F

WATER WELL DRILLERS LOG

8-25-61

Date: 8-25, 1961, Driller: J.C. REEVES County LOWNDES
 (Name)

(1) Owner of Land: W.E. ATCHLEY
 (Name)
COLUMBUS, Miss.
 (Address)

(2) Location: 1/4, 1/4, Sec. T R
8 miles WEST, of COLUMBUS
 (distance) (direction) (Nearest Town)

(3) Topography: FLAT
 (Hilly) (Flat) (Level)

(4) Purpose of Well: DOM
 (Domestic Irrigation
 Municipal, Industrial, Other)

Description & Color of Materials Sand, Clay, Red Clay, Shell, etc.	Thick- ness Feet.	Depth Feet
<u>CLAY</u>	<u>14</u>	<u>0</u>
<u>BLUE CLAY</u>	<u>129</u>	<u>14</u>
<u>" SAND</u>	<u>16</u>	<u>143</u>
<u>" CLAY</u>	<u>64</u>	<u>159</u>
<u>" SAND</u>	<u>11</u>	<u>223</u>
<u>" CLAY</u>	<u>87</u>	<u>234</u>
<u>" SAND</u>	<u>23</u>	<u>257</u>
<u>" CLAY</u>	<u>13</u>	<u>344</u>
<u>" SAND</u>	<u>38</u>	<u>357</u>

Information upon completion of well:

(1) Diameter 4 inches.

(2) Total Depth 395 feet.

(3) Water Level 51 feet below top of ground.

(4) Cased to 21', Size 4"


(5) Screen: Size , Length

(6) Were any formations sealed against pollution?
 yes, no.

If YES depth of formation

Why

Drillers Remarks:

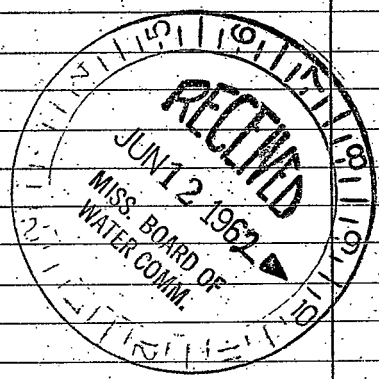

(Use Back Side)

Well No.

THE HISTORY OF THE

Faint, illegible text covering the majority of the page, appearing to be a historical document or manuscript.