

MISSISSIPPI DEPARTMENT OF NATURAL RESOURCES

Bureau of Land and Water Resources

Southport Mall

P.O. Box 10631

Jackson, Mississippi 39209

WATER WELL DRILLERS LOG

CODED

LANDNES  
8-30-85

8/30/85  
date well completed

Clardy Well Drilling Lowndes  
firm name county well located

LANDOWNER: Carl Holloway  
107 Dunbrook Dr.  
Starville, ms -  
(mailing address)

WELL LOCATION: T18S R07E  
sec. 3 T. 18N R. 7E  
5 miles NW of Col. S  
(distance) (direction) (nearest town)

WELL PURPOSE: home  
(home, irrigation, municipal, industrial)

- WELL COMPLETION DATA:
- (1) diameter (inches) 4"
  - (2) total depth (feet) 293'
  - (3) static water level (feet) 50' below top of ground.
  - (4) casing PVC 209' (material) (depth)  
4" (size) if telescope see back.
  - (5) screen 40' (length) (depth to top)  
2" (size) PVC (material)
  - (6) pump 1 1/2 (HP) 40 (yield gpm)  
elec. (type power)
  - (7) electric log no (yes or no)  
(organization running log)
  - (8) how well bottom plugged

description of formations encountered	from	to
Lime rock	0	10
brown clay	10	15
blue clay	15	19
rock	19	27
sandy & rocky	27	130
sand	130	137
sandy clay	137	156
soft blue clay	156	162
shaly clay	162	180
sand & silt	180	193
sandy clay	193	197
sands	197	200
rock	200	205
sandy clay	205	208
good blue clay	208	210
rocky	210	219
gummy clay	219	230
good blue clay	230	248
sandy	248	250
sand	250	254
rock	254	256
sand	256	256
rock	256	262
sand	262	265
fine sand	265	272
good sand	272	293

RECEIVED  
OCT - 7 1985

DRILLERS REMARKS:  
Pump set 120'


Department of Natural Resources  
Bureau of Land & Water Resources

If well telescopes please sketch and show depths.

GROUND LEVEL



If more than one screen, show locations of each on sketch.

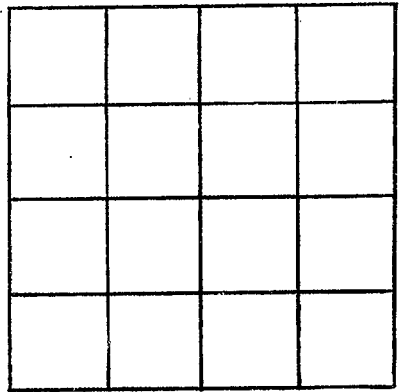

SECTION \_\_\_\_\_

Please indicate well location X.

ADDITIONAL INFORMATION

Horizontal lines for additional information.