

CODED
CODED
301

MISSISSIPPI
BOARD OF WATER COMMISSIONERS
416 North State Street
Jackson, Mississippi 39201

WATER WELL DRILLERS LOG

Lowndes
730
1-69

Lowndes 1969 Clardy Well Drilling Lowndes
date well completed firm name county well located

LANDOWNER: S. F. Williams

description of formations encountered	depth	
	from	to
Sand & gravel	0	30
Sandy blue clay	30	45
Hard, sandy blue clay	45	135
blue clay	135	140
Sand (fine)	140	150
blue clay	150	210
Coarse sand	210	230

Hwy 82 W.
Columbus, Miss.
(mailing address)

WELL LOCATION:
sec 35 T 19 N R 17 E
2 miles W of Colo.
(distance) (direction) (nearest town)

WELL PURPOSE:
(home, irrigation, municipal, industrial)

- WELL COMPLETION DATA:
- (1) diameter (inches) 4"
 - (2) total depth (feet) 230'
 - (3) static water level (feet) 12' below top of ground.
 - (4) casing Steel 47' (material) (depth)
 - (5) screen (length) (depth to top) (size) (material)
 - (6) pump (HP) (yield gpm) (type power)
 - (7) electric log (yes or no) (organization running log)
 - (8) how well bottom plugged

CODED


MAR 11 1969

DRILLERS REMARKS:

MISS. Bd. of WATER

If well telescopes please sketch and show depths.

GROUND LEVEL

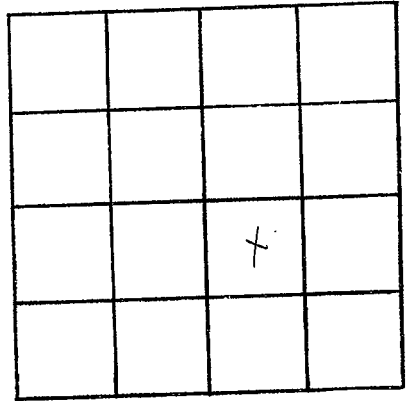

SECTION 25

Please indicate well location X.

ADDITIONAL INFORMATION

If more than one screen, show locations of each on sketch.