

Lowndes Co.
 F-32
 4-28-70

MISSISSIPPI
 BOARD OF WATER COMMISSIONERS
 416 North State Street
 Jackson, Mississippi 39201

CODED

WATER WELL DRILLERS LOG

4/28 1970 ALLSUE DRILLING CO. Lowndes
 date well completed firm name county well located

LANDOWNER:
 AL Dobbs
 Columbus, Miss
 (mailing address)

description of formations encountered	from	to
CLAY	0	12
BLUE Rock	12	57
SAND	57	89
MUCK	89	137
SAND + Rock	137	249

WELL LOCATION:
 sec 15 T 19 N R 17 E
 4 1/2 miles W of Columbus
 (distance) (direction) (nearest town)

WELL PURPOSE: HOME
 (home, irrigation, municipal, industrial)

WELL COMPLETION DATA:

(1) diameter (inches) 4" x 2"
 (2) total depth (feet) 249
 (3) static water level (feet) 46 below top of ground: above
 (4) casing PLASTIC 199'
 (material) (depth)
 (size) if telescope see back.
 (5) screen 84' 165'
 (length) (depth to top)
 2" PLASTIC
 (size) (material)
 (6) pump 1
 (HP) (yield gpm)
 ELECTRIC
 (type power)
 (7) electric log No
 (yes or no)
 (organization running log)
 (8) how well bottom plugged CAT

CODED

MAY 22 1970

MISS. B.D. CO.
 WATER COMMISSION

DRILLERS REMARKS:


If well telescopes please sketch and show depths.

GROUND LEVEL

21'
4" CASING

45'
ROCK

192'
2" CASING

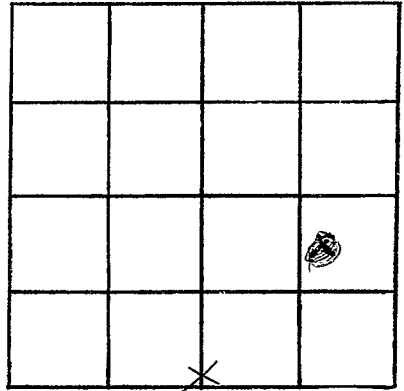

SECTION 15

Please indicate well location X.

ADDITIONAL INFORMATION

If more than one screen, show locations of each on sketch.