

LOWNOES

F 34

3-10-71

MISSISSIPPI  
 BOARD OF WATER COMMISSIONERS  
 416 North State Street  
 Jackson, Mississippi 39201

**CODED**

WATER WELL DRILLERS LOG

3-10

date well completed

71 Anthony Dill Co.

firm name

Lowndes

county well located

LANDOWNER:

Don Sanders HW455

Columbus, Miss 3274309  
(mailing address)

description of formations encountered

from

to

Clay

0

5'

Blue Limestone

5

215

Sand & Shale

215

385

WELL LOCATION:

sec 34 T 19 N R 17 E  
3 miles west of Col.  
(distance) (direction) (nearest town)

WELL PURPOSE: Home  
(home, irrigation, municipal, industrial)

WELL COMPLETION DATA:

- (1) diameter (inches) 4 1/2
- (2) total depth (feet) 385
- (3) static water level (feet) 60 below above top of ground.
- (4) casing iron 20' below above top of ground.  
(material) (depth)
- 4 1/2 if telescope see back.  
(size)
- (5) screen 84' (length) (depth to top)  
2" iron pipe (size) (material)
- (6) pump 1/2 10 (HP) (yield gpm)  
Elet (type power)
- (7) electric log no (yes or no)

(organization running log)

(8) how well bottom plugged fine split & best closed

DRILLERS REMARKS:



**CODED**

APR - 2 1971

MISS. B.D. WATER

If well telescopes please sketch and show depths.

GROUND LEVEL

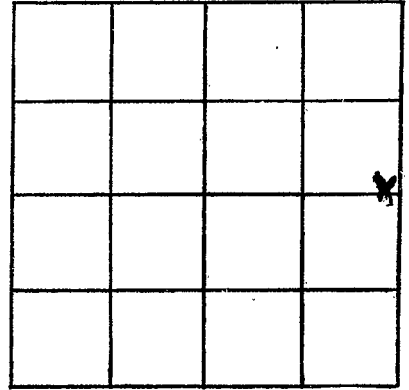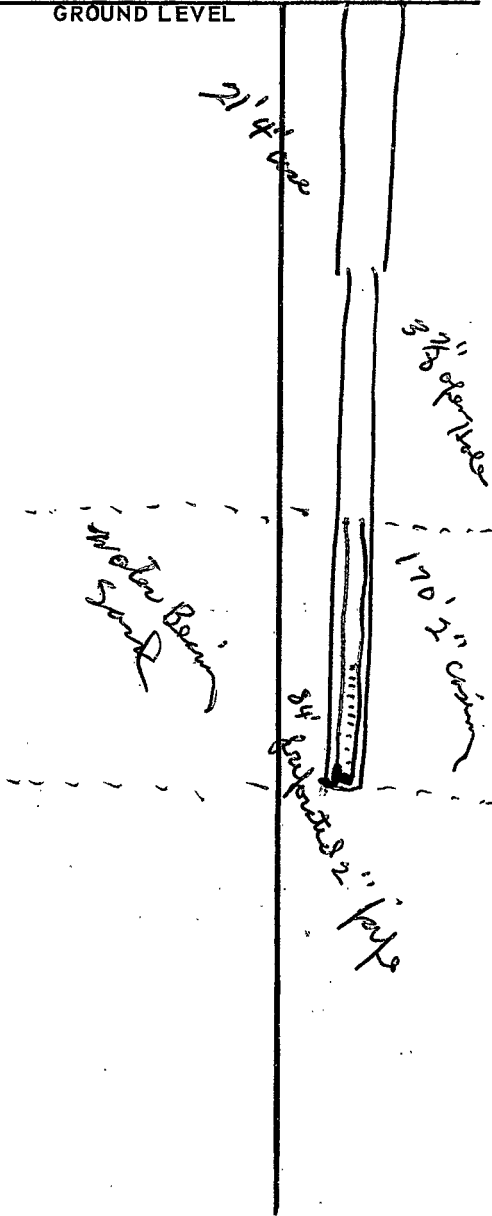

SECTION 34

Please indicate well location X.

ADDITIONAL INFORMATION

Lined area for additional information.

If more than one screen, show locations of each on sketch.