

F39

WATER WELL DRILLERS LOG

CODED

12-28-62

Date: Dec. 28, 1962, Driller: W.B. Clardy County: Lounis

16489

(Name)

(1) Owner of Land: Laurence Moody

(Name)

A.W. 82W 328.0270

(Address)

(2) Location: SE NE SE 1/4, 1/4, Sec. 32 T19 N R12 E

7 miles W of Calhoun (distance) (direction) (Nearest Town)

(3) Topography: (Hilly) (Flat) (Level)

(4) Purpose of Well: Domestic (Domestic Irrigation, Municipal, Industrial, Other)

Description & Color of Materials Sand, Clay, Red Clay, Shell, etc.

Thick-ness Feet

Depth Feet

Clay (Blue) 15'
Sand 200' - 220'
Clay 220' - 360'
Sand 360' - 390'

Information upon completion of well:

- (1) Diameter 4 inches.
(2) Total Depth 390' feet.
(3) Water Level 51' feet below top of ground.
(4) Cased to 42 1/2', Size 4
(5) Screen: Size, Length
(6) Were any formations sealed against pollution?


yes, no.

If YES depth of formation

Why

Drillers Remarks:

CODED

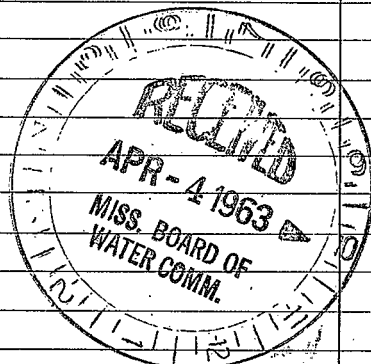

(Use Back Side)

Well No.

1875

...

...

...