

LOWNDES

MISSISSIPPI BOARD OF WATER COMMISSIONERS

12-30-65

WATER WELL DRILLERS LOG

CODED

Date: 12-30, 1965, Driller: J. C. REEVES County LOWNDES

(When well drilled)

16392

(Name)

(Where well is located)

(1) Owner of Land: ROBERT ENGLEHART (Name)

(Name)

3282833

OLD WEST POINT RD., COLUMBUS (Address)

SW SE NE

(2) Location: 1/4, 1/4, Sec. 23 T19N R17E

6 miles W of COLUMBUS (distance) (direction) (Nearest Town)

(3) Topography: LEVEL (Hilly) (Flat) (Level)

(4) Purpose of Well: DOMESTIC (Domestic Irrigation Municipal, Industrial, Other)

Description & Color of Materials Sand, Clay, Red Clay, Shell, etc.

Thick-ness Feet

Depth Feet

SOIL

1

YELLOW CLAY

17 1

BLUE CLAY

8 18

BLUE SANDY CLAY

48 26

BLUE SAND

4 74

BLUE CLAY

29 78

BLUE SAND

8 127

BLUE CLAY

72 135

BLUE SAND

8 207

BLUE CLAY

16 215

BLUE SAND

26 231

BLUE CLAY

3 257

Information upon completion of well:

(1) Diameter 4 inches.

(2) Total Depth 260 feet.

(3) Water Level 30 feet below top of ground.

(4) Cased to 100', Size 4"

(5) Screen: Size _____, Length _____

(6) Were any formations sealed against pollution?

yes, no.

If YES depth of formation _____

Why _____


Drillers Remarks:

Yield in gpm: 40 GPM - AIR COMP.

Size pump: 3/4 HP. SUB - 10 GPM

Type power: ELECTRIC

CODED

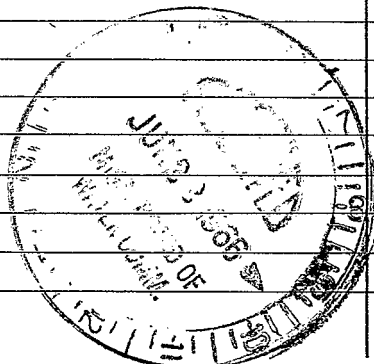

Mail this copy to Board of Water Commissioners 429 Miss. St. Jackson, Miss.

