

MISSISSIPPI
BOARD OF WATER COMMISSIONERS
416 North State Street
Jackson, Mississippi 39201

CODED

WATER WELL DRILLERS LOG

LOWNDES
F61
5-26-72

5-26 1972 W. J. REEVES & SON LOWNDES
date well completed firm name county well located

LANDOWNER: R. E. THOMPSON

description of formations encountered

from to

R.T. I

COLUMBUS

(mailing address)

CLAY	0	11
BLUE CLAY	11	132
SANDY BLUE CLAY	132	210
BLUE CLAY	210	247
BLUE SAND	247	265
BLUE CLAY + SAND STRS.	265	380

WELL LOCATION:

sec. 35 T 19 N R 17 E
4 miles W of COLUMBUS
(distance) (direction) (nearest town)

WELL PURPOSE: HOME
(home, irrigation, municipal, industrial)

WELL COMPLETION DATA:

- diameter (inches) 4
- total depth (feet) 380
- static water level (feet) 84 below top of ground.
- casing STEEL, 38 (material) (depth)
4 (size) if telescope see back.
- screen NONE (length) (depth to top)
(size) (material)
- pump 1/2 (HP) 8 (yield gpm)
ELECT (type power)
- electric log NO (yes or no)

(organization running log)

(8) how well bottom plugged OPEN

CODED


NOV 14 1972

DRILLERS REMARKS:

MISS. RD. OF
WATER COMMISSIONERS

If well telescopes please sketch and show depths.

GROUND LEVEL

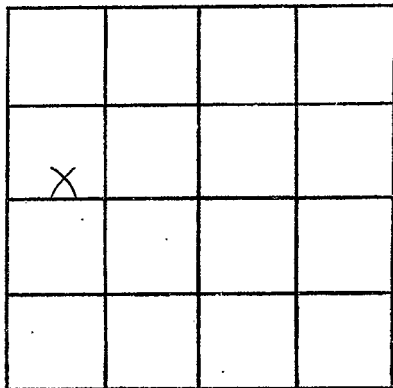

SECTION 35

Please indicate well location X.

ADDITIONAL INFORMATION

If more than one screen,
show locations of each on sketch.