

LOWNDES
F65
1-19-73


MISSISSIPPI
BOARD OF WATER COMMISSIONERS
416 North State Street
Jackson, Mississippi 39201

CODED

WATER WELL DRILLERS LOG

1/19 date well completed 1973 Norman E. Ehl firm name Lowndes county well located

LANDOWNER:	description of formations encountered	from	to
<u>1502 SEMINOLE RD.</u>	<u>Sandy clay</u>	<u>0</u>	<u>17</u>
<u>Columbus Miss</u>	<u>Chalk</u>	<u>17</u>	<u>160</u>
(mailing address)	<u>Sand & light clay</u>	<u>160</u>	<u>400</u>
	<u>Clay & Rock</u>	<u>400</u>	<u>440</u>
WELL LOCATION:			
sec. <u>32</u> T. <u>19</u> (N) S. R. <u>17</u> (E) W.			
<u>5</u> miles <u>WEST</u> of <u>Columbus</u>			
(distance) (direction) (nearest town)			
WELL PURPOSE:			
(home, irrigation, municipal, industrial)			
WELL COMPLETION DATA:			
(1) diameter (inches) <u>5"</u>			
(2) total depth (feet) <u>440</u>			
(3) static water level (feet) <u>2</u> below top of ground.			
(4) casing <u>21</u> (material), <u>5"</u> (depth)			
(size) If telescope see back.			
(5) screen <u> </u> (length), <u> </u> (depth to top)			
(size) (material)			
(6) pump <u>34</u> (HP), <u>10</u> (yield gpm)			
<u>E. Ehl</u> (type power)			
(7) electric log <u>NO</u> (yes or no)			
(organization running log)			
(8) how well bottom plugged			
DRILLERS REMARKS:			

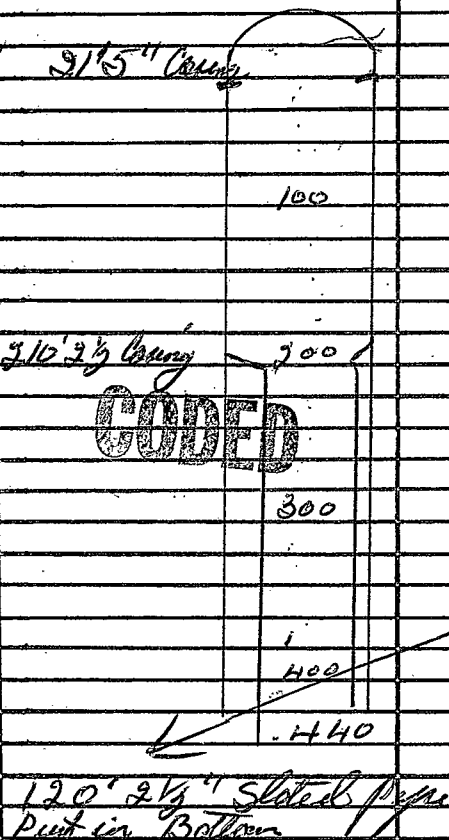

If well telescopes please
sketch and show depths.

GROUND LEVEL

SECTION _____

Please indicate well location X.

ADDITIONAL INFORMATION

If more than one screen,
show locations of each on sketch.