

LOWMEDES  
F 68  
6-6-73

MISSISSIPPI  
BOARD OF WATER COMMISSIONERS  
416 North State Street  
Jackson, Mississippi 39201

CODED

WATER WELL DRILLERS LOG

6-6 date well completed    223 W.T. REEVES 2 SON firm name    LOWMEDES county well located

LANDOWNER: ALVIN STEEL BUILDINGS, INC. COLUMBUS  
(mailing address)

description of formations encountered	from	to
BLUE CLAY	0	70
SANDY BLUE CLAY	70	190
BLUE SD + CLAY	190	225
" CLAY	225	248
" SD + CLAY	248	375
" CLAY	375	400

WELL LOCATION:  
sec. 36 T 19 N R 17 E  
2 miles W of COLUMBUS  
(distance) (direction) (nearest town)

WELL PURPOSE: STOCK  
(home, irrigation, municipal, industrial)

- WELL COMPLETION DATA:
- (1) diameter (inches) 4
  - (2) total depth (feet) 400
  - (3) static water level (feet) 91 below above top of ground.
  - (4) casing STU 21  
(material) (depth)  
4 if telescope see back.  
(size)
  - (5) screen \_\_\_\_\_  
(length) (depth to top)  
(size) (material)
  - (6) pump 3/4 8  
(HP) (yield gpm)  
ELECT  
(type power)
  - (7) electric log No  
(yes or no)  
(organization running log)
  - (8) how well bottom plugged OPEN


CODED

DRILLERS REMARKS:

OCT 30 1973  
MISS. Bd. of WATER COM. STAMP

If well telescopes please sketch and show depths.

GROUND LEVEL

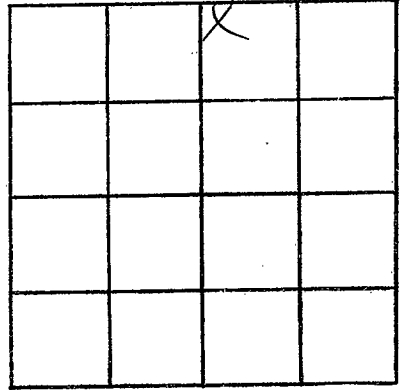

SECTION 35

Please indicate well location X.

ADDITIONAL INFORMATION

If more than one screen, show locations of each on sketch.