

LOWMEDES
R F 71
7-12-74

MISSISSIPPI
 BOARD OF WATER COMMISSIONERS
 416 North State Street
 Jackson, Mississippi 39201

CODED

WATER WELL DRILLERS LOG

July 12, 1974 Cloudwell Pump Lowmes
 date well completed firm name county well located

LANDOWNER: Rev. Benton

Halbert Rd

Columbus Miss.
 (mailing address)

WELL LOCATION:

sec. 29 T 19 N R 17 E
 S* W
10 miles S of Col
 (distance) (direction) (nearest town)

WELL PURPOSE: home
 (home, irrigation, municipal, industrial)

WELL COMPLETION DATA:

- (1) diameter (inches) 4"
- (2) total depth (feet) 285
- (3) static water level (feet) 28 below top of ground.
- (4) casing 4" steel (material), 75' (depth)
- _____ if telescope see back. (size)
- (5) screen _____ (length), _____ (depth to top)
- _____ (size), _____ (material)
- (6) pump 1/2 Sub (HP), 12 (yield gpm)
- _____ (type power)
- (7) electric log _____ (yes or no)
- _____ (organization running log)
- (8) how well bottom plugged _____

description of formations encountered	from	to
red clay	0	18
clay gravel + sand	18	45
sandy blue clay	45	70
blue clay	70	90
sandy blue clay	90	105
five sand	105	120
blue clay	120	155
sandy blue clay	155	180
blue clay	180	225
five sand + clay	225	255
sand + rocks	255	285

CODED


RECEIVED
 JUL 22 1974

MISS. BD. OF WATER COMM

DRILLERS REMARKS:

If well telescopes please sketch and show depths.

GROUND LEVEL

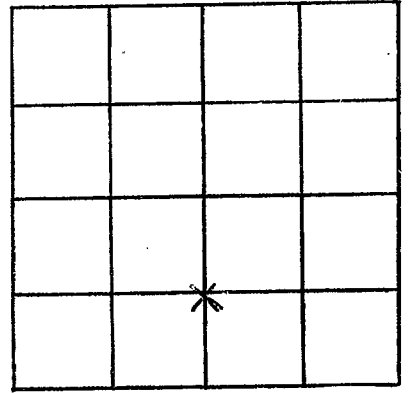

SECTION 29

Please indicate well location X.

ADDITIONAL INFORMATION

If more than one screen,
show locations of each on sketch.