

LOWNDES
F75
C/76

MISSISSIPPI
BOARD OF WATER COMMISSIONERS
 416 North State Street
 Jackson, Mississippi 39201
WATER WELL DRILLERS LOG

WELL
#2

June 1976 Herndon Well & Supply, Inc. Lowndes
 date well completed firm name county well located


LANDOWNER: City of Columbus	description of formations encountered	from	to
Columbus, MS	Red Sandy Clay	0	5
(mailing address)	Sand	5	15
WELL LOCATION:	Gravel	15	20
sec. 12 T 18 XX S R 19 XX W	Blue Sand (Very Tight)	20	112
Inside Columbus	Chalky Clay	112	120
(distance) miles (direction) of (nearest town)	Sand	120	127
WELL PURPOSE:	Blue Clay COVER	127	152
(home, irrigation, municipal, industrial)	Sand	152	155
WELL COMPLETION DATA:	Blue Clay	155	190
(1) diameter (inches) 6 x 3"	Sand(Strks of Clay)	190	241
(2) total depth (feet) 630	Rock	241	424
(3) static water level (feet) 76.5 below top of ground.	Sand	242	257
(4) casing Steel, 248 (material), (depth) 6	Rock	257	258
(size) If telescope see back.	Clay	258	263
(5) screen 62 (length), 570 (depth to top)	Rock	263	264
3" SS (size) (material)	Clay	264	288
(6) pump SEE OVER (HP) (yield gpm)	Sand	288	292
(type power)	Sand and Rocks	292	294
(7) electric log (yes or no)	Soft Sandy Clay(Rocks @ 303, 305, 307, 310)	294	312
(organization running log)	Gray Clay	312	326
(8) how well bottom plugged	Sand	326	330
	Gray Clay	330	385
	Sand (Good)	385	408
	Blue Clay	408	440
	Pink Clay	440	480
	Sand	480	483
	Pink Clay	483	525
	Sand	525	530
	Blue Clay	530	536
	Sand (Some Gravel)	536	620
	Blue Clay	620	630

RECEIVED
 SEP 16 1976

DRILLERS REMARKS:

MISS. Bd. OF WATER COMMISSIONERS

If well telescopes please sketch and show depths.

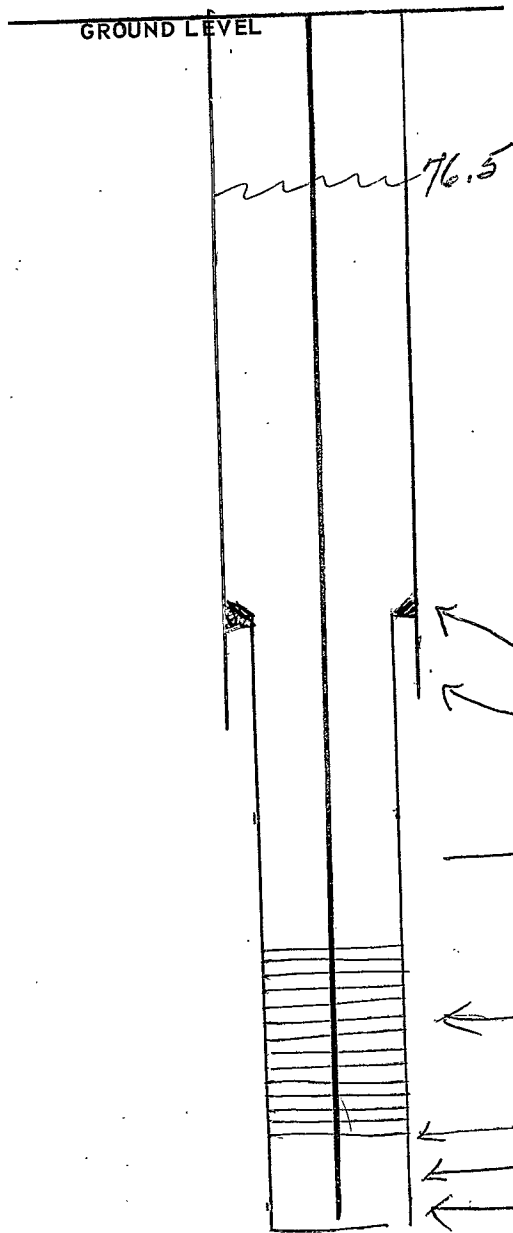

			+

SECTION 12

Please indicate well location X.

ADDITIONAL INFORMATION

234' LEAD SEAL
248' CASING 6"
BLANK 3"
62' SCREEN 3" .05"
609'
-21'
630' BOTTOM WELL

If more than one screen, show locations of each on sketch.