

LOWNDES

F76

7/76

MISSISSIPPI
 BOARD OF WATER COMMISSIONERS
 416 North State Street
 Jackson, Mississippi 39201

COLORED

TEST WELL #5

WATER WELL DRILLERS LOG

July 19 76 Herndon Well & Supply, Inc. Lowndes
 date well completed firm name county well located

LANDOWNER:

City of Columbus

Columbus, MS

(mailing address)

WELL LOCATION:

sec. 34 T 19 N R 17 E
 XXX XXX

Inside _____ miles _____ of _____
 (distance) (direction) (nearest town)

WELL PURPOSE: Municipal Test
 (home, irrigation, municipal, industrial)

WELL COMPLETION DATA:

- (1) diameter (inches) 6 x 3
- (2) total depth (feet) 654
- (3) static water level (feet) 76.5 below
 top of ground. above
- (4) casing Steel 248
 (material) (depth)
6 if telescope see back.
 (size)
- (5) screen 62 570
 (length) (depth to top)
3" SS
 (size) (material)
- (6) pump _____ 223
 (HP) (yield gpm)

 (type power)
- (7) electric log (yes or no)
USES
 (organization running log)
- (8) how well bottom plugged _____

description of formations encountered

from to

Gray Clay	0	120
Blue Clay Sandy	120	170
Blue Rock	170	273
Blue Clay Sandy (Rock at 300-301)	273	340
Sand	430	360
Blue Clay (Numerous strks of sand)	360	512
Sand (Clay Breaks)	512	560
Sand	560	630
Blue Clay	630	640
Sand	640	650
Blue Clay	650	653


DRILLERS REMARKS:

RECEIVED
 SEP 10 1976

MISS. Bd. OF WATER COMMISSIONERS

(18)

If well telescopes please sketch and show depths.

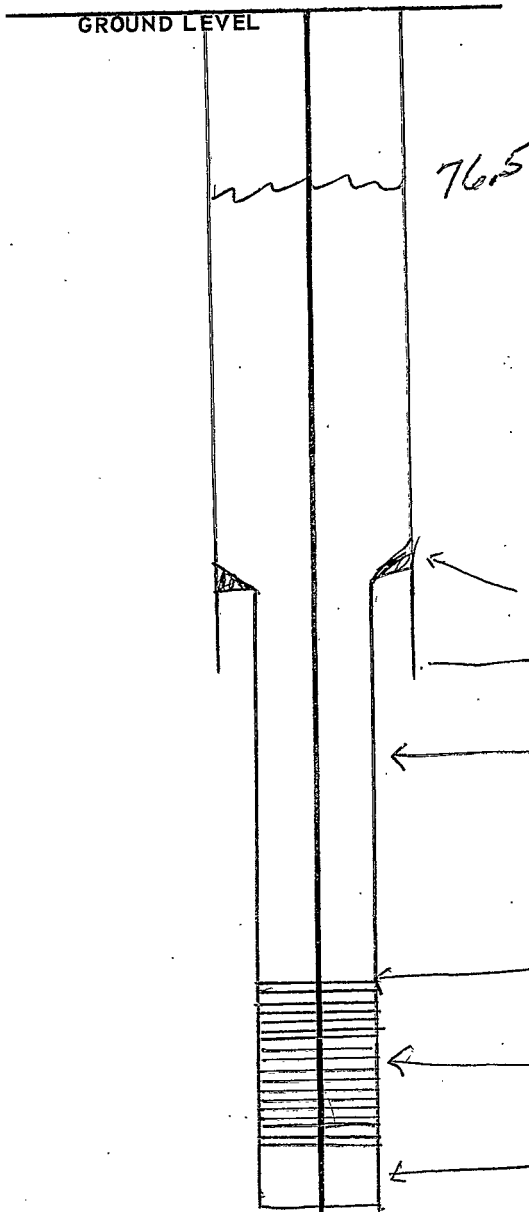

			X

SECTION 34

Please indicate well location X.

ADDITIONAL INFORMATION

LEADSEAL 234'

248' CASING 6"

336" ABOVE SCREEN

570'

102' .015 3"

21' BELOW SCREEN

If more than one screen, show locations of each on sketch.