

LOWNDES Co.  
F79  
10/9/81

MISSISSIPPI  
BOARD OF WATER COMMISSIONERS  
416 North State Street  
Jackson, Mississippi 39201  
WATER WELL DRILLERS LOG

CODED

9 October 1981 Herndon Well & Supply, Inc. Lowndes  
date well completed firm name county well located

LANDOWNER: Weyerhaeuser Co. Regional Building Columbus, MS (mailing address)	description of formations encountered	from	to
		Brown Clay	0
	Limerock	10	50
	Blue Clay	50	200
	Sandy Blue Clay	200	220
	Blue Clay	220	250
	Sandy Blue Clay	250	315
	Hard Rock	315	320
	Blue Clay	320	450
	Sand	450	560
	Sandy Clay	560	590
		590	

WELL LOCATION:  
sec. 26 T. 09 N R. 17 E  
3 miles West of Columbus  
(distance) (direction) (nearest town)

WELL PURPOSE: Municipal  
(home, irrigation, municipal, industrial)

WELL COMPLETION DATA:

- (1) diameter (inches) 8 x 4"
- (2) total depth (feet) 523'
- (3) static water level (feet) 66.47 <sup>below</sup> ~~above~~ top of ground.
- (4) casing Steel 460  
(material) (depth)  
8" if telescope see back.  
(size)
- (5) screen 62.26 461'  
(length) (depth to top)  
4" SS Ribbed  
(size) (material)
- (6) pump 10 99  
(HP) (yield gpm)  
Electric  
(type power)
- (7) electric log yes  
(yes or no)  
U.S. Geo. Survey  
(organization running log)
- (8) how well bottom plugged 4"  
Brass BWV

MISSISSIPPI DEPT. OF NATURAL RESOURCES  
BUREAU OF LAND & WATER RESOURCES

FEB 15 1982

RECEIVED


DRILLERS REMARKS:

(X)

If well telescopes please sketch and show depths.

GROUND LEVEL

Stattie W.L.  
66.47'

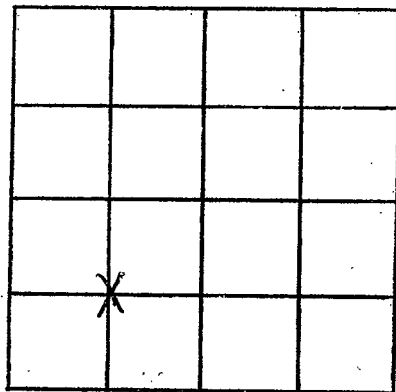

SECTION 26

Please indicate well location X.

ADDITIONAL INFORMATION

Top LAP  
400'

Top Screen  
461'

Bottom Screen  
523'

Bottom casing 760'

If more than one screen, show locations of each on sketch.