

MISSISSIPPI DEPARTMENT OF NATURAL RESOURCES

Bureau of Land and Water Resources

Southport Mall

P.O. Box 10631

Jackson, Mississippi 39209

WATER WELL DRILLERS LOG

CODED

Lowndes
~~5-199~~ F85
 4/16/85

4-16-85 19 Clardy Well Drilling Lowndes
 date well completed firm name county well located

LANDOWNER: Dan Pippins
Hwy 82 W
Colo, Ms.
 (mailing address)

WELL LOCATION:
 sec. 34 T 18 N R. 18
2 miles W of Colo.
 (distance) (direction) (nearest town)

WELL PURPOSE: home
 (home, irrigation, municipal, industrial)

- WELL COMPLETION DATA:
- (1) diameter (inches) 4"
 - (2) total depth (feet) 242
 - (3) static water level (feet) 23' below above-top of ground.
 - (4) casing PVC, 81'
 (material) (depth)
4"
 (size) If telescope see back.
 - (5) screen _____
 (length) (depth to top)
 (size) (material)
 - (6) pump 1/2 850 gph
 (HP) (yield gpm)
 - elec.
 (type power)
 - (7) electric log no
 (yes or no)
 - (organization running log) _____
 - (8) how well bottom plugged _____

description of formations encountered	from	to
sand	0	10
sand & gravel	10	43
sandy clay	43	73
good clay	73	83
sandy clay	83	124
good clay	124	135
rock	135	135 1/2
sandy clay	135 1/2	164
gummy clay	164	170
rock 2"		
sandy clay	170	190
sand	190	206
sandy clay	206	218
sand	218	242

CODED


RECEIVED
 MAY 23 1985

DRILLERS REMARKS:

Department of Natural Resources
 Bureau of Land & Water Resources

If well telescopes please
sketch and show depths.

GROUND LEVEL

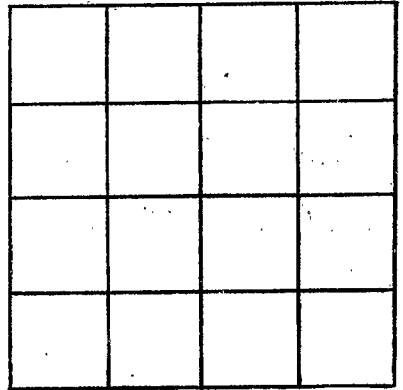

SECTION _____

Please indicate well location X.

ADDITIONAL INFORMATION

If more than one screen,
show locations of each on sketch.