

MISSISSIPPI DEPARTMENT OF NATURAL RESOURCES
Bureau of Land and Water Resources
 Southport Mall
 P.O. Box 10631
 Jackson, Mississippi 39209
WATER WELL DRILLERS LOG

CODED

LOWNDES
~~86206~~ F86
 4/23/85

4-23-85 19 Cloudy Well Drilling Lowndes
 date well completed firm name county well located

LANDOWNER: Robert Nelson
Hwy 82 W
Columbus, Ms-
 (mailing address)

WELL LOCATION:
 sec. 34 T 18 N R. 18 W
2 miles W of Cols.
 (distance) (direction) (nearest town)

WELL PURPOSE: Home
 (home, irrigation, municipal, industrial)

WELL COMPLETION DATA:

- (1) diameter (inches) 4"
- (2) total depth (feet) 244'
- (3) static water level (feet) 22' below above top of ground.
- (4) casing PVC, 91'
 (material) (depth)
 (size) if telescope see back.
- (5) screen _____
 (length) (depth to top)
 (size) (material)
- (6) pump 1/2 850 gpd
 (HP) (yield-gpd)
elec.
 (type power)
- (7) electric log no
 (yes or no)
 (organization running log)
- (8) how well bottom plugged _____

description of formations encountered	from	to
sand	0	24
sand & gravel	24	46
sandy clay	46	85
good clay	85	113
sandy clay	113	134
rock 2"		
sandy clay	134	168
hard clay	168	193
sandy clay	193	205
sand	205	210
rock 2"		
sand	210	213
sandy clay	213	215
sand	215	244

CODED


RECEIVED
 MAY 23 1985

DRILLERS REMARKS:

Department of Natural Resources
 Bureau of Land & Water Resources

If well telescopes please sketch and show depths.

GROUND LEVEL

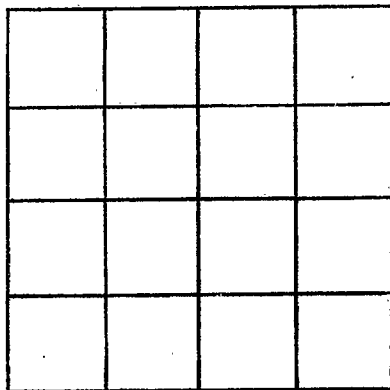

SECTION _____

Please indicate well location X.

ADDITIONAL INFORMATION

If more than one screen,
show locations of each on sketch.