

**MISSISSIPPI DEPARTMENT OF ENVIRONMENTAL QUALITY**

Office of Land and Water Resources

P. O. Box 10631  
Jackson, MS 39289-0631  
**WATER WELL DRILLERS LOG**

COUNTY WELL LOCATED <u>Bounded</u>	
WELL NUMBER <u>F-94</u>	CODED
DATE WELL COMPLETED <u>12/13/02</u>	

PERMIT NUMBER
NAME OF DRILLING FIRM <u>Clardy Well</u> <u>Columbus, MS</u>

NAME & MAILING ADDRESS OF LANDOWNER <u>Steve Jamison</u> <u>83 Noble Dr.</u> <u>Columbus, MS</u>
Latitude: Longitude:
WELL LOCATION. SEC TOWNSHIP RANGE <u>22 19 N 17 E</u>
DISTANCE DIRECTION NEAREST TOWN <u>4</u> Miles <u>W</u> of <u>Columbus</u>
OTHER LANDMARK
WELL PURPOSE: Home, Irrigation, Municipal, Industrial, Fish Pond, etc. <u>Home</u>

PUMP DATA			
PUMP TYPE (Circle One): <u>Submersible</u> , Turbine, Jet, Flowing Well, Other (Describe)			
POWER TYPE (Circle One): <u>Electric</u> , Tractor, Diesel, Gasoline, Butane, Other (Describe) <u>H/P 1</u>			

DESCRIPTION OF FORMATIONS ENCOUNTERED	FROM	TO
<u>Gray + white clay</u>	<u>0</u>	<u>18</u>
<u>Blue clay</u>	<u>18</u>	<u>65</u>
<u>Sandy clay</u>	<u>65</u>	<u>167</u>
<u>Clay</u>	<u>167</u>	<u>178</u>
<u>Sand streak</u>	<u>178</u>	<u>181</u>
<u>Clay</u>	<u>181</u>	<u>206</u>
<u>Hard sand</u>	<u>206</u>	<u>220</u>
<u>Sand</u>	<u>220</u>	<u>242</u>
<u>Clay</u>	<u>242</u>	<u>243</u>

WELL DATA		
Well Depth <u>243</u>	Casing Diameter (In.) <u>4"</u>	Casing Length (Ft.) <u>162'</u>
Type of Casing <u>PVC</u>	Hole Depth <u>58'</u>	Depth to Static Water Level
TYPE OF COMPLETION: (Circle One or More): Gravel Packed, Underreamed, Telescoped, Natural Development, Open Hole, Other (Describe)		
WELL GROUTED TO A DEPTH OF <u>20</u> FEET Type Grout (circle one): Cement, <u>Bentonite</u> , or Mix		

SCREEN DATA		
Diameter - Inches <u>2"</u>	Length - Feet <u>40'</u>	Slot Size - Inches <u>.013</u>
Screen Type <u>PVC</u>	Depth to Bottom - Feet	


<b>RECEIVED</b>	
<b>DEC 18 2002</b>	
<b>BY: OLWR</b>	
Top of Lap Pipe or Reduction in Casing	IF TELESCOPED OR MORE THAN ONE SCREEN: USE BACK PAGE

I certify that the well was drilled, constructed and completed in accordance with all applicable Requirements of the Mississippi Department of Environmental Quality and/or the Mississippi Department of Health regulations and state laws.

Steve Jamison 0-496  
Signature of Licensed Driller and License No.

12/14/02  
Date

If well telescopes please sketch and show depths.

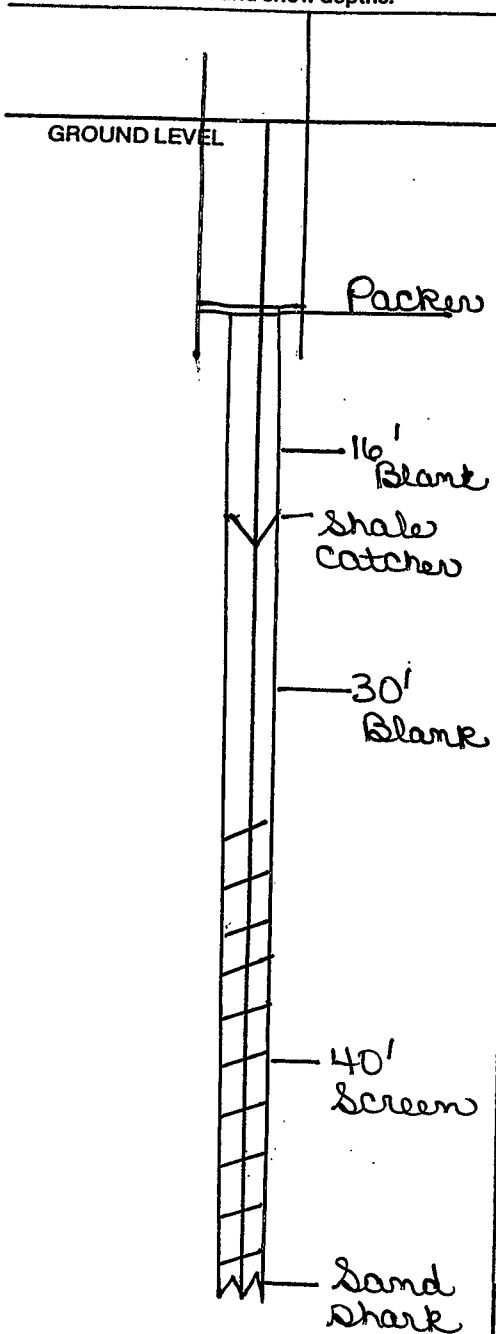

If more than one screen, show location of each on sketch.


SECTION \_\_\_\_\_

Please indicate well location X.

Pump Capacity (GPM)	No. of Stages	Setting Depth
15	12	120 FT.
PUMP TEST		
Well yielded _____ GPM with a drawdown of _____ ft. after _____ hours of pumping		

LOG DATA

TYPE OF LOG RUN (Circle One):  No Log Run,  Electric,  Gamma Ray,  Density,  Sonic,  Neutron,  Other (Describe) \_\_\_\_\_

Name of Organization Running Log \_\_\_\_\_

GEOLOGIC DATA (Office Use Only)

Surface Elev.	Geologic Unit	Unit Thickness	Depth to Top
Subs. SWL	Date	Analysis	Aquifer Test

Driller's Remarks

\_\_\_\_\_

\_\_\_\_\_

