
County: Lowades	Part 1 – Driller's Log		
(-14/- // 129 Missis	Mississippi Department of Environmental Quality		Aquifer: MSSV
		and Water Resources	Well #:F- 96
Driller: James Kirk	P.O. Box 10631 Jackson, MS 39289-0631		•
Date drilling completed: Q-7-06		961-5210	L. S. Elevation:
		4-6938 (fax)	E-log #:
	` ,	` ′	
State Law requires that this report be pre Department at the above address within			
Information on Well Owner		Well or Bo	rehole Location
(Landowner if borehole is not for a water	er well)	1 asimulas 20 ° 10 25 11	7 I amaidadadada 0.7 a. 207217
Owner Name Loundes County Wat	we Assor	Landoc. 20 200	" Longitude <u>\$8. °30. '23W</u> "
<u> </u>	_	Method of Lat/Long (circle on	e): Conventional Survey,
Mailing Address: 150 Actesia	Goad_	USGS quad, (Hand-held GPS) Survey-grade GPS	
		SEV SULV 5- 20	Twn 19 N Rng 17 E
CM Endmulas	3970 l		TWILTIN RIIG TIE
City State	Zip Code	Distance Direction	Nearest Town
Talanhana No. (,	8 Miles west	of Columbus
Telephone No. ()			
	Well / Bore	hole Data	
Date drilling started: 5.13-06 Date drilling completed: 8.7-06 Hole depth: 1342 Hole diameter: 97/8"			
Location of the source of any surface water used fo	or drilling: NA		İ
Method of dosing and volume of Chlorine used in	drilling and devel	opment: Pumped 1	SALS.
Logs run (circle all applicable): No log run <u>Electronic Name of organization running log(s):</u> No log run <u>Electronic Name of organization running log(s):</u>	rici Cramma Ray	Density Sonic Neutron (Ther:
Purpose of borehole (check one): Water Well \(\subseteq \)	eotechnical/Geolo	ogical Investigation Ground	Source Heat Pump
Seismic Survey	Other (describe)	•	
Seismic Survey Other (describe) If drilling is not related to water well construction, skip the remainder of this block			
Purpose of Well (check one): Home Industrial Public Supply \(\nstar{\text{V}} \) Irrigation Fish Culture Other:			
If a flowing well, method of flow regulation: Valve	Ot	ther (describe)	
Static Water Level: 15 feet above or 15	low (circle one) la	and surface Date measured:	1/28/06
Method of Measurement (circle one) steel tape <u>electric tape</u> air line other:			
Well depth: 1330 Well grouted to a depth of 1245 feet Type of grout (circle one) Neat Cement Bentonite Mix			
Casing length: 1245 feet Casing diameter: 12 inches Type of casing: Cocted			
Screen length: 80 feet Screen diameter: 8 inches Type of screen: 30km Son Stainless			
Screen slot size: 0.020 inches Setting depth: From 1250 feet to 1330 feet			
Type of completion (circle all applicable): Gravel packed Underreamed Telescoped Open hole Natural Development			
Other (describe):			
Top of lap pipe or reduction in casing: 1190 feet. If telescoped or more than one screen, describe on next page			

State Well Report

APR 2 4 2007 BY: OLWR

F-96

The sketch below only required for water wells

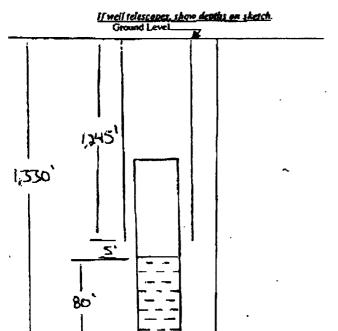

Description of formations encountered must be provided for all wells and bercholes, unless specifically exempted by regulations

Description of Formations Encountered	From (depth)	To (depth)
Brown Clay	Ground Level	
Lime fock	<u> </u>	110
Mux Clay Strate + Sand	116	150
Sand + Shalk	130	185
Chu sand + Shalt	185	322
Clay shalt + sand	33 <i>5</i>	180
Clair sand & shale	280	23~1
Clar & Shale	777	437
_ Sand + Hard Shale	רגצ	450
Sond, CLAY & Shale	450	530
Sand + Shale	022	579
Sound Piak Bumbio	579	400
Pink Girabo + Pink Clay	ပ်ဝဂ	640
Pix K Bumbs & Hand	480	645
Muse Clay		<u> </u>
There elav	645	703

	· · · · · · · · · · · · · · · · · · ·	
		1

4) a north an	ow.		1
Laest Point	well_1e		
	, , , , , , , , , , , , , , , , , , ,	Herry 82	Columbe
S			
٦			
4			

I certify that the well/horehole was drilled, constructed, and completed in accordance with all applicable requir Mississippi Department of Environmental Quality and the Environmenta

Print Name of Responsible Licensee and License No.

RECEIVED

APR 2 1 2007

BY: OLWA

STATE WELL REPORT

Permit #: Driller: Onald Smith Co Date completed: 41007 Copy information from block on Part 1

Part 2

Pump Installer's Completion Report Mississippi Department of Environmental Quality

Office of Land and Water Resources
P.O. Box 10631
Jackson, MS 39289-0631
(601)961-5210
(601)354-6938 (fax)

For Office Use Only:		
Aquifer:		
Well #:	F-96	
Elevation:		

Copy information from block on Part I	(601)35	4-6938 (fax)	Elevation:
This part of the report must be completed by a licensed water well contractor or a licensed pump installer. A copy of Part 1 of the report must be attached and both parts filed with the Department at the above address within 30 days of well completion.			
Well Owner Informat	ion		Location
Owner Name: LOWN des C		Latitude:	Longitude:
Mailing Address: 150 Artes	ia Rd	Method of Lat/Long (check one	e): Conventional Survey,
		USGS quad, Hand-held (GPS) , Survey-grade GPS
Columbus MS 39701 City State Zip Code		¼¼ Sec_2	_
	-	Distance Direction	
Telephone No. ()_			Columbus
Down Torne			
Pump Type Circle one			er Type cle one
Air Lift Jet	Submersible	Diesel Engine Gasoline	Engine Natural Gas
Bucket Piston	Turbine	Electric Motor Hand	Tractor PTO
Centrifugal Rotary	Flowing Well	Windmill Other (sp	pecify):
Other (specify):		Horse Power Rating of Motor:	75
Date Pump Installed: 2/6/2007		Setting Depth: _/80 '	feet
Rated Pump Capacity:(Gallons Per Minute	Number of Stages:	
D			
Pump Test Data			uring Water Level
Date Well Tested: 4/4/2007	1	Air Line Electric Measur	
Static Water Level (A): Feet Below Land Surface			_
Tot Delow Land Surface		Other (specify):	
Drawdown [(B) – (A)]: 53 Feet Below Land Surface		For flowing well, measured shut	in head:feet
Test Pumping Rate: 184 Gallons Per Minute		Well yielded <u>184</u> GPM with a drawdown of	
Duration of Pump Test (minimum 4 hours):	hours	feet after	hours of pumping

I HEREBY CERTIFY that the above statements are true to the best	of my knowledge	
Donald E Snith 0-767	Donald & Smith	RECEIVED
Print Name of Pump Installer and License No. (if applicable)	Signature of Pump Installer	2 EVE - 0 - 1
		Form: TLWR-SWAUNE

BY: OLWA