	State Well R	- 1	For Office Use Only:	
County: Joundee	Part 1 – Driller		Aquifer: F102	
Permit #:	Mississippi Department of Env Office of Land and Wate		• •	
	D O Box 230	1	Well #:	
Driller: Clandy Bulline	1 · · ·		L. S. Elevation:	
Date drilling completed:	(601)961- 52 (601)961- 5228			
I ((iuxy	E-log #:	
State Law requires that this report Department at the above address				
Information on Well O	WRAT I	Wall on Do	mhole Location	
(Landowner if borehole is not for	r a water well)	Nan of ALL	36 W 22 259	
Owner Name Donny The	Latituc	ie: 03° 08 '67	36 W	
	Matha		e): Conventional Survey,	
Mailing Address: 2745 S. Frontage			<u> </u>	
Bd. O		ISGS guad Hand-held	GPS, Survey-grade GPS	
	And man the	1/1 NE 1/4 Sec 32	Twn 19 NRng 7E	
Columbruo City State			Naamat Taur	
			Nearest Town of	
Telephone No. (da) 574-D	<u>477</u>		<u> </u>	
	Well / Borehole Dat	a	······	
Date drilling started: 7 14 11 Date dril	ling completed: <u>115</u> []] Ho	le depth: <u>260</u>	Hole diameter:	
Location of the source of any surface water	used for drilling:			
Method of dosing and volume of Chlorine	used in drilling and development:	a latt o	randular	
Logs run (circle all applicable): No log run	`			
Name of organization running log(s):	Liccure Gamma Ray Densit	y some neuron (Juici.	
Demos of heart of the state of			0	
Purpose of borehole (check one): Water We	IIV Geotechnical/Geological In	vestigation Ground	Source Heat Pump	
Seismic Survey Other (<i>describe</i>)				
If drilling is not related t	o water well construction, skip th	ne remainder of this blo	<u>ck</u>	
Purpose of Well (check one): Home	dustrial Public Supply Irrig	ationFish Culture	Other:	
If a flowing well, method of flow regulation				
Static Water Level:feet abo	ve of below (dircle one) land surfa	the Date measured:	11511	
Method of Measurement (circle one) ste	el tape electric tape air	line other:		
Well depth: 200 Well grouted to a dep	th of Deet Type of grout	(circle one): Neat Ceme	ent Bentonite Mix	
	diameter: inches			
	n diameter: <u> </u>			
Screen slot size: 013 inches	Setting depth: From	D feet to <u>a</u>	40 feet	
Type of completion (circle all amplicable)	Gravel packed Underreamed	elescoped Open h	ole Natural Development	
Type of completion (circle all applicable):	•			
Type of completion (circle an applicable):	Other (describe):			
Top of lap pipe or reduction in casing:	Other (describe):		1, describe on next page	


÷

AUG 1 5 2011 BY: OLWR

F102

Description of formations encountered must be provided for all

The sketch below only required for water wells

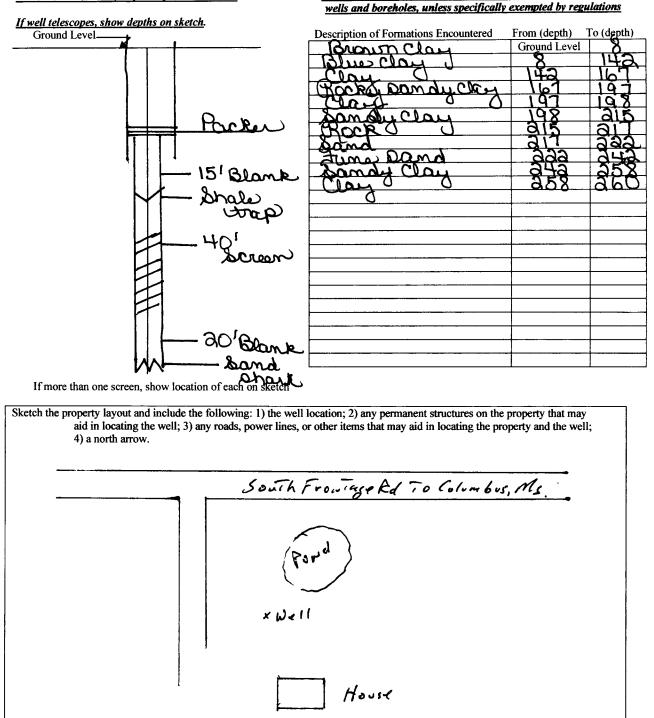

Janny Thornton Form: OLWR-SWR-1A (04/08)

I certify that the well/borehole was drilled, constructed, and completed in accordance with all applicable requirements of the Mississippi Department of Environmental Quality and the Mississippi Department of Health regulations, if applicable, and state

laws. 496 LINROCOCO 8/11/11 Dondel BClack see and License No. Date Signature of Licensee Uonald Clardy Print Name of Responsible Licensee and License No.

Landowner Name:



AUG 1 5 2011 90 🛛

STATE WELL REPORT				
Pump Installer'	art 2 s Completion Report th of Environmental Quality Aquifer			
Office of Land	and Water Resources			
	well #: <u>Floa</u>			
	Elevation:			
This part of the report must be completed by a licensed water well contractor or a licensed pump installer. A copy of Part 1 of the report must be attached and both parts filed with the Department at the above address within 30 days of well completion.				
Well Owner Information	Well Location			
Owner Name: Danny Thornton	Latitude: 33° 28.616 Longitude: 088° 32.158			
Mailing Address: 2745 S. Frontage				
<u>-Rd.</u>	USGS quad, Hand-held GPS, Survey-grade GPS			
City State Zin Code	¼¼ SecTR			
	Distance Direction Nearest Town			
Telephone No. (do2) 574-0977	6 Miles Westor Columbra			
Pump Type Circle one	Power Type Circle one			
Air Lift Jet Submersible	Diesel Engine Gasoline Engine Natural Gas			
Bucket Piston Turbine	Electric Motor Hand Tractor PTO			
Centrifugal Rotary Flowing Well	Windmill Other (specify):			
Other (specify):	Horse Power Rating of Motor:			
Date Pump Installed: 7 30 11	Setting Depth:feet			
Rated Pump Capacity: 10 Gallons Per Minute	Number of Stages:			
Pump Test Data	Method of Measuring Water Level			
Date Well Tested: 7 20 11	Circle one			
Static Water Level (A):Feet Below Land Surface	Air Line Electric Measuring Line Steel Tape			
Pumping Water Level (B):Feet Below Land Surface	Other (specify):			
Drawdown [(B) – (A)]:Feet Below Land Surface	For flowing well, measured shut in head:feet			
Test Pumping Rate:Gallons Per Minute	Well yielded GPM with a drawdown of			
Duration of Pump Test (minimum 4 hours):hours	feet afterhours of pumping			
I HEREBY CERTIFY that the above statements are true to the best of my knowledge. Dona Id Clardy UNRD0000496 Dec H/B T/LS Print Name of Pump Installer and License No. (if applicable) Signature of Pump Installer				
Finit Name of Pump Installer Signature of Pump Installer Form: OLWR-SWR-1B (04/08)				

• r

RECEIVED

4UG 1 5 **2011** BV: OLWIR