	- State W	ell Report	
County: Inmdee	Part 1 – Driller's Log		For Office Use Only:
County: Ounded		t of Environmental Quality	Aquifer: $+103$
Permit #:	Office of Land a	and Water Resources	Well# E-29
Driller: Clandy Quillo,		30x 10631 4S 39289-0631	L. S. Elevation:
Date drilling completed		961-5210	L. S. Elevation.
	(601)354-6938 (fax)		E-log #:
State Law requires that this repo	et he prepared by the lic	ense holder responsible for i	the work and filed with the
Department at the above address	s within 30 days of com	pletion of drilling of the well	or borehole.
Information on Well	Owner	Well or Be	orehole Location
(Landowner if borehole is not j	for a water well)	Latitude: 33 . 30 . 27	" Longitude: <u>88° 32, 33</u> "
Owner Name H.B. Wuinul		_	
Acilian Addams FLLILL D.D.	A^{0} $+$ P + R	Method of Lat/Long (circle one): Conventional Survey,	
Mailing Address: 5414 Old W. P.E. Kd.		USGS quad, Hand-held GPS, Survey-grade GPS	
		S 1/4 E 1/4 Sec LA	Twn 19N Rng 10E
Columbrus, MS 39701 City State Zip Code		1 5F 5W 17 11F	
		Distance Direction Nearest Town <u>H</u> Miles <u>West</u> of <u>Columbus</u>	
Telephone No. 602 328-	1479		
	Well / Bor	ehole Data	
Date drilling started: 711607 Date d	rilling completed:	U Hole depth: ATA	Hole diameter:
Location of the source of any surface wa Method of dosing and volume of Chlori	ter used for drilling: ne used in drilling and deve	elopment: <u>ala</u>	grandular
Logs run (circle all applicable) No log r Name of organization running log(s):	un) Electric Gamma Ray	Density Sonic Neutron	Other:
Purpose of borehole (check one): Water	Well Geotechnical/Geo	logical Investigation Groun	d Source Heat Pump
Seismi	c Survey Other (<i>describ</i>	0)	RECE
If drilling is not relate	ed to water well construction	on, skip the remainder of this b	lock
Purpose of Well (check one): Home	Industrial Public Suppl	y Irrigation Fish Culture	Other: AUG 03
•			BY: OU
If a flowing well, method of flow regulat			BY: OLI
Static Water Level: <u>73</u> feet	above on below circle one)	land surface Date measured:	-1/18/01
Method of Measurement (circle one)	steel tape electric tap	e air line other:	•
Well depth: <u>243</u> Well grouted to a	lepth of <u>AD</u> feet Typ		_
11.0	sing diameter: <u>411</u>		ργυ
		inches Type of some	
Screen length: <u>HO</u> feet Sc			
Screen length: <u>HO</u> feet Sc Screen slot size: <u>CB</u> inches	Setting depth: From	aDa_feet to_2	142_feet
Screen length: <u>HO</u> feet Sc	Setting depth: From	erreamed Telescoped Ope	n hole Natural Development
Screen length: <u>HO</u> feet Sc Screen slot size: <u>1013</u> inches	Setting depth: From	aDa_feet to_2	n hole Natural Development


F103

The sketch below only required for water wells

Description of formations encountered must be provided for all wells and boreholes, unless specifically exempted by regulations

If well telescopes, show depths on sketch.			
Ground Level 1	Description of Formations Encountered	<u></u>	To (depth)
	Brown + Yuhite Clay	Ground Level	18
	Blue clay	18	511/2
	Rock O	5712	58"a
	Clain	5812	62.
	Sandy Clay	<u>La</u>	92
	ROCKYO	<u>92</u>	
Packen	Sandaj clay	91	147 12
	Rock 0 0	147 Va	148 Va
	Hard sandy clay	148/2	160
	Sandy clay 0	160	16412
-19' Beank	Clay 0 0	16412	190
brale	Sandy clay	190	1900
III attened	Sand Ostraak	200	aD8
20'Blank	Clay	<u>908</u>	an
-du Blank	Sand, Streak	all	aaa
	Sandy clay	232 237 238	agi
	Bocky loand strak	<u>aan</u>	238 242
	Sandy clay	<u>a38</u>	1 <u>a4a</u>
	0 0		4
-40' Screen			
			41
H	· · · · · · · · · · · · · · · · · · ·		<u> </u>
H			
W_Sand shark	L	L	1
If more than one screen, show location of each on sketch			

If more than one screen, show location of each on sketch

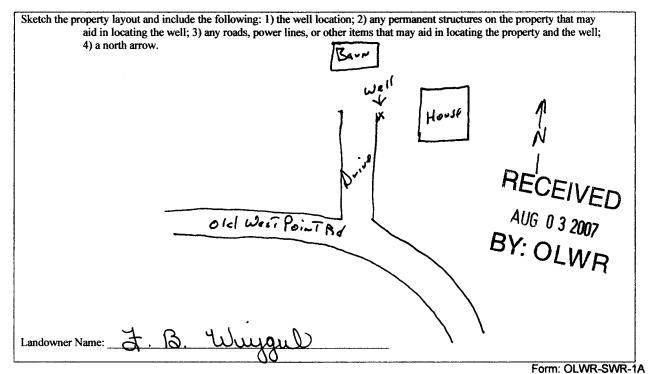

I certify that the well/borehole was drilled, constructed, and completed in accordance with all applicable requirements of the Mississippi Department of Environmental Quality and the Mississippi Department of Health regulations, if applicable, and state

laws. Dowald B. Claudy 0-496 7/30/07 and Billy

Date

Print Name of Responsible Licensee and License No.

Signature of Licensee

STATE WELL REPORT						
County: <u>Soundes</u> Permit #: Driller: <u>Clandy</u> Date completed: <u>Jacob</u> <u>Copy information from block on Part 1</u>	Part 2 Pump Installer's Completion Report Mississippi Department of Environmental Quality Office of Land and Water Resources P.O. Box 10631 Jackson, MS 39289-0631 (601)961-5210 (601)354-6938 (fax)		For Office Use Only: Aquifer: F103 Well #: E-29 Elevation:			
report must be attached and both parts file Well Owner Informati	ed with the Department a ion	contractor or a licensed pump installer. A copy of Part 1 of the at the above address within 30 days of well completion. Well Location				
Owner Name: <u>F. B. Wujoul</u> Mailing Address: <u>5414 Old W.Pt.</u> Rd. <u>Columbrue</u> , <u>MS</u> 39102 City State Zip Code		Latitude: Longitude: Method of Lat/Long (check one): Conventional Survey, USGS quad, Hand-held GPS, Survey-grade GPS SE % SE 5 W Sec 15 T 19N R 16E Distance Direction 7 Nearest Town 17E				
Telephone No. 602 328-1479		Distance Direction Nearest Town				
Pump Type Circle one Air Lift Jet Bucket Piston Centrifugal Rotary Other (specify):	Submersible Turbine Flowing Well	C Diesel Engine Gasolin Electric Motor Hand				
Rated Pump Capacity:		Number of Stages:				
Pump Test Data Date Well Tested:	Below Land Surface Below Land Surface	Method of Me C Air Line Electric Mea Other (specify): For flowing well, measured sh	suring Line Steel Tape			
Test Pumping Rate:		Well yieldedfeet after	GPM with a drawdown ofhours of pumping			

ľ

I HEREBY CERTIFY that the above statements are true to the best of my knowledge. Donald B. Clardy O-496 Print Name of Pump Installer and License No. (if applicable) Signature of Pump Installer Form: OLWR-SWR-1B