

Lowndes
 F 2000
 4-3-75

MISSISSIPPI
 BOARD OF WATER COMMISSIONERS
 416 North State Street
 Jackson, Mississippi 39201

WATER WELL DRILLERS LOG

4-3 1975 W. J. REEVES & SON LOWNDES
 date well completed firm name county well located


LANDOWNER: EDMOND VON KANEL
 RT. 3
 COLUMBUS
 (mailing address)
 WELL LOCATION: 13L
 sec. 19 T. 19 N. R. 17 E
 8 miles W of COLUMBUS
 (distance) (direction) (nearest town)

description of formations encountered	from	to
CLAY	0	14
BLUE CLAY	14	235
" SAND	235	247
" CLAY	247	293
" SAND	293	312
" CLAY	312	330
" SAND	330	400

WELL PURPOSE: HOME
 (home, irrigation, municipal, industrial)

WELL COMPLETION DATA:
 (1) diameter (inches) 4
 (2) total depth (feet) 400
 (3) static water level (feet) 117 below top of ground.
 (4) casing STEEL, 39' (material) (depth)
 4" (size) if telescope see back.
 (5) screen NONE (length) (depth to top)
 (size) (material)
 (6) pump 3/4 (HP) 8 (yield gpm)
 ELECT (type power)
 (7) electric log NO (yes or no)
 (organization running log)
 (8) how well bottom plugged OPEN

DRILLERS REMARKS:

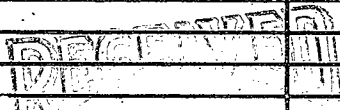


NOV 24 1975

MISS. BD. OF WATER COMMISSIONERS

If well telescopes please sketch and show depths.

GROUND LEVEL

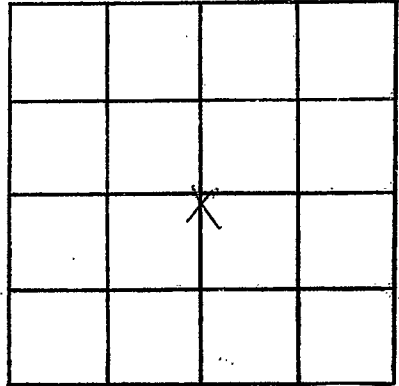

SECTION 19

Please indicate well location X.

ADDITIONAL INFORMATION

If more than one screen,
show locations of each on sketch.